

NOV 15 1994

LAND CORNER RECORDATION CERTIFICATE
Filing Requirement of Act 74, Mich. P.A. 1970

LIBER 003 PAGE 0243

For corners in

Lake (County)	Located In:	Corner Code #
1. Public Land Survey	T 17N R 11W	K-1
	T R	
	T R	
	T R	
2. Property Controlling in Section	S T R	
	S T R	
3. Miscellaneous Property in Sec.	S T R	
	S T R	

REGISTER OF DEEDS
Richard M. DeWitt
 OCT 27 3 23 PM '94
 LAKE COUNTY, MI.
 REGISTERED

Register of Deeds Stamp & File Number

4. Lot No. _____, Recorded Plat _____
 5. Private Claims _____

	A	B	C	D	E	F	G	H	I	J	K	L	M
2	6	5	4	3	2	1							
3													
4	7	8	9	10	11	12							
5													
6	18	17	16	15	14	13							
7													
8	19	20	21	22	23	24							
9													
10	30	29	28	27	26	25							
11													
12	31	32	33	34	35	36							
13													

I, Robert L. Wetherell, in a field survey on October 10, 1994
do hereby certify that under requirements of P.A. 74, Michigan P.A. of 1970, the corner points mentioned
in lines 1 and 2 above were in conformance with regulations and rules therefore as required in the
current manual of survey instructions of the United States Department of the Interior, Bureau of Land
Management or by a decree of a Court of Law and/or that the corner points mentioned in lines 3, 4 and 5
above were in conformance with the rules of the Michigan Board of Land Surveyors or by a Decree of a
Court of Law; established, re-established, monumented, re-monumented, recovered, found as
expressed below:

**NOTE: Not more than 4 corners, all in the same town and range, may be recorded
on this certificate.**

A. Description of original monument and accessories and/or subsequent restoration:

K-1 - Section corner common to Sections 1 and 2, on township line, T17N, R11W, Chase Twp., Lake Co., Mi.

1838 - John Hodgson, D.S., G.L.O.

- #1 - 14" Hemlock S36°W 16 Links
- #2 - 18" Hemlock S24°E 33 Links
- #3 - Standard corner West 68 Links

1924 - George Johnson, Co. Sur.

- Large stone with "X" on top and iron pipe.
- #4 23" B. Oak N48°30'E 135' 1/4 Cor. Sec's 1 & 2 (T17N, R11W) South 2497'.

1991 - Robert L. Wetherell, L.S. 24624

- #5 - 12" W. Pine S82°W 251.03'
- #6 - 12" W. Pine N83°W 371.93'
- #7 - Power Pole S52°E 56.25'
- #8 - G. Pole N65°E 54.66'

B. Description of corner evidence found and/or method applied in restoring or reestablishing corner:

K-1 - Section corner common to Sections 1 and 2, on township line, T17N, R11W, Chase Twp., Lake Co., Mi.


I found 1-1/4" square headed bolt 3.5 feet East of centerline North and South blacktop road. I found large Black Oak stump N46°E 136 feet more or less (accessory #4). I measured a distance of 2498.65 feet to the 1/4 corner of Sections 1 and 2 (T17N, R11W) which is consistent with Johnson's distance in 1924. I measured 2604 feet more or less East to a fence line running South. Condition of the accessories are as follows: #1 Gone, #2 Gone, #3 Set, #4 Found stump, #5 Found in good condition, #6 Found in good condition, #7 Found in good condition, #8 Found in good condition.

C. Description of monument for corner and accessories established to perpetuate locating the position of the corner:

K-1 - Section corner common to Sections 1 and 2, on township line, T17N, R11W, Chase Twp., Lake Co., Mi.

I replaced the 1-1/4" bolt with a 3/4" x 24" re-bar with Lake County Brass Cap monument (set in monument box) and is accepted as a careful and faithful re-establishment of the position of the original corner.

- 12" W. Pine S82°W 251.03' (#5) (60d spike in South side of tree)
- 12" W. Pine N83°W 371.93' (#6) (60d spike in North side of tree)
- Power Pole S52°E 56.25' (#7) (Found nail and cap in North side)
- 3/4" Re-bar with Brass Cap - West 44.88' (3/4" x 24" re-bar with Lake County Brass Cap)

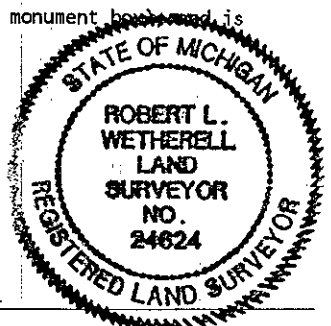

Signed by Robert L. Wetherell Date 10-26-94
 24624

Surveyor's Michigan License No. _____ RATIFIED BY THE LAKE CO. PEER REVIEW GROUP
 IN ACCORDANCE WITH P.A. 345

CHAIRMAN RZW
 DATE 10-25-94