

SURVEY & REMONUMENTATION

AUG 31 1999

LAND CORNER RECORDATION CERTIFICATE

FILING REQUIREMENT OF ACT 74, Mich. P.A. 1970

RECORDED
LAKE COUNTY, MI.

LIBER 004 PAGE 0186
JUL 23 3 02 PM '99

SECTION

For corners in
Lake _____

Located in: Corner Code#

- | | | | |
|---|-------|-------|-----|
| 1. Public Land Survey | T 17N | R 11W | M-5 |
| | T | R | |
| | T | R | |
| | T | R | |
| 2. Property Controlling s
in Section | T | R | |
| | S T | R | |
| 3. Miscellaneous
Property in Sec. | S T | R | |
| | S T | R | |
| 4. Lot No. _____ Recorded Plat _____ | | | |
| 5. Private Claims _____ | | | |

Christina H. DeChau
REGISTER OF DEEDS

Register of Deeds Stamp & File Number

I, Robert L. Wetherell, in a field survey on June 1, 1999, do hereby certify that under requirements of P.A. 74, Michigan P.A. of 1970, the corner points mentioned in lines 1 and 2 above were in conformance with regulations and rules therefore as required in the current manual of survey instructions of the United States Department of the Interior, Bureau of Land Management or by decree of a Court of Law and/or that the corner points mentioned in lines 3, 4, and 5 above were in conformance with the rules of the Michigan Board of Land Surveyors or by a Decree Of a Court of Law; established, re-established, monumented, re-monumented, recovered, found as expressed below:

	A	B	C	D	E	F	G	H	I	J	K	L	M
1													
2	6	5	4	3	2	1							
3													
4	7	8	9	10	11	12							
5													
6	18	17	16	15	14	13							
7													
8	19	20	21	22	23	24							
9													
10	30	29	28	27	26	25							
11													
12	31	32	33	34	35	36							
13													

M-5 - Section corner common to Sections 12 & 13, T17N, R11W

A. Description of original monument and accessories and/or subsequent restoration:

1837 - J. Hodgson, G.L.O.

#1 - 10" Sugar S17°W 10 Links
#2 - 10" Sugar N65°W 56 Links

1979 G. Gray, LS 17741

L.C.R.C. - L. 02, Pg. 132
(Osc. Co. Reg. Deeds)
Found 1/2" Iron

1988 - R. L. Wetherell, LS 24624

#6 - 6" Apple S72°W 91.30'
#7 - P. Pole S59°E 126.93'
#8 - P. Pole N36°E 66.01'

1905 - F. Trumbull (Osc. Co. Sur.

Showed distance of 2556.84' North
to 1/4 corner and 2515.26 East to 1/4 cor.

#3 - Tri. Maple N20°W 101.56'

#4 - St. Sign N50°E 52.35'
#5 - Fence Post S45°E 44.16'

1990 - J. McLane, LS 28415

Same witnesses as G.Gray in 1979

B. Description of corner evidence found and/or method applied in restoring or reestablishing corner:

I found a 10" dock spike directly over an old 3/4" x 18" pipe. Corner in centerline of roads North, South, East and West. I measured 2630.49 feet North to 1/4 corner and 2638.39 feet East to 1/4 corner.


Condition of the accessories are as follows: #1 Gone, #2 Gone, #3 Found in good condition, #4 Found in good condition, #5 Gone, #6 Found in good condition, #7 Found in good condition, #8 Found in good condition.

C. Description of monument for corner and accessories established to perpetuate locating the position of the corner:

I set a 3/4" x 24" re-bar with Lake County Remon Cap directly over old pipe and is accepted as a careful and faithful re-establishment of the position of the original corner.

Corner Fence Post N48°E 57.48' (P.K. nail in N.W. side)
P. Pole S59°E 126.83' (60d spike in S. side) #7
8" Tw. Apple S73°W 91.60' (Fd. Nail in S. side) #6
Corner Fence Post S38°E 52.10' (P.K. nail in S.W. side)
P. Pole N36°E 66.02' (60d spike in S.E. side) #8

WITNESSED BY THE LAND SURVEYORS REVIEW GROUP
IN ACCORDANCE WITH P.A. 345
CHAIRMAN *rdw*
DATE 7-20-99

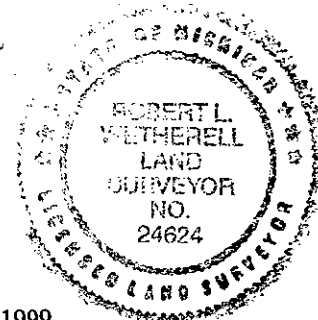

Signed by Robert L. Wetherell

Date June 21, 1999

Surveyor's Michigan License No. 24624