

FEB 18 1994

LAKE COUNTY REMONUMENTATION

RECORDED LAKE COUNTY, MI.

LIBER 003 PAGE 0195

DEC 13 3 42 PM '93

COMMISSION

LAND CORNER RECORDATION CERTIFICATE Filing Requirement of Act 74, Mich. P.A. 1970

REGISTER OF DEEDS

For corners in Lake

Table with columns: (County), Located In: (17 N, 12 W), Corner Code: # (B-13). Rows include Public Land Survey, Property Controlling in Section, and Miscellaneous Property in Sec.

Register of Deeds Stamp & File Number

4. Lot No. , Recorded Plat
5. Private Claims

Grid table with columns A-M and rows 2-13. A dot is marked at row 12, column B.

Robert L. Wetherell December 1, 93

I, in a field survey on 19 do hereby certify that under requirements of P.A. 74, Michigan P.A. of 1970, the corner points mentioned in lines 1 and 2 above were in conformance with regulations and rules therefore as required in the current manual of survey instructions of the United States Department of the Interior, Bureau of Land Management or by a decree of a Court of Law and/or that the corner points mentioned in lines 3, 4 and 5 above were in conformance with the rules of the Michigan Board of Land Surveyors or by a Decree of a Court of Law; established, re-established, monumented, re-monumented, recovered, found as expressed below:

NOTE: Not more than 4 corners, all in the same town and range, may be recorded on this certificate.

A. Description of original monument and accessories and/or subsequent restoration:

B-13 - S. 1/4 Corner, Section 31, T17N, R12W, on the County Line

1837 - John Hodgson, D.S., G.L.O.

Placed wood stake
#1 26" Pine N76°W 31 Links
#2 24" Pine N33°E 27 Links

Undated - George Johnson, County Surveyor

#3 12" W. Oak N38°W 83.5'

1955- George Blass, LS 5489

Set 1-1/4" Well Point by single proportionate distance
#4 12" Elm N82°W 51.74'
#5 12" J. Pine N68°W 13.09'
#6 3" Maple N12°E 22.94'

B. Description of corner evidence found and/or method applied in restoring or reestablishing corner:

B-13 - S. 1/4 Corner, Section 31, T17N, R12W, on the County Line

I found and accepted George Blass's 1-1/4" Well Point. Condition of the recorded witnesses are: #1 Gone, #2 Gone, #3 Found Stump, #4 Found down, #5 Found in good condition, #6 Found in good condition.


C. Description of monument for corner and accessories established to perpetuate locating the position of the corner:

B-13 - S. 1/4 Corner, Section 31, T17N, R12W, on the County Line

I replaced 1-1/4" Well Point with a 3/4" x 24" re-rod with Lake County Brass Cap and is accepted as a careful and faithful re-establishment of the position of the original corner.

15" J. Pine N68°W 13.35' (tree scribed S. 1/4,) (60d spike in NE side of tree) (#5)
6" R. Maple N12°E 22.54' (60d spike in SE side of tree) (#6)
6" R. Maple S87°E 60.53' (60d spike in NE side of tree)
5" W. Pine S35°W 80.07' (60d spike in NW side of tree)

Signed by Robert L. Wetherell Date 12-13-93
Surveyor's Michigan License No. LS 24624

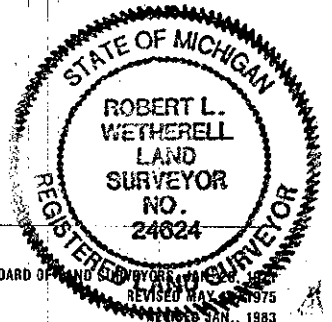

Approved by Peer Review Group December 6, 1993
Robert L. Wetherell, County Representative