

SURVEY & REMONUMENTATION

JAN 14 1998

LAND CORNER RECORDATION CERTIFICATE
Filing Requirement of Act 74, Mich. P.A. 1970

For corners in **SECTION**
 Lake _____ (County)

RECORDED
LAKE COUNTY, MI.
LIBER 004 PAGE 0094

Dec 12 11 38 AM '97

Lucinda H. DeChant
REGISTER OF DEEDS

Register of Deeds Stamp & File Number

Located In:	Corner Code #
1. Public Land Survey T <u>17N</u> R <u>12W</u>	C-9
T _____ R _____	_____
T _____ R _____	_____
T _____ R _____	_____
2. Property Controlling in Section S _____ T _____ R _____	_____
S _____ T _____ R _____	_____
3. Miscellaneous Property in Sec. S _____ T _____ R _____	_____
S _____ T _____ R _____	_____

4. Lot No. _____, Recorded Plat _____
 5. Private Claims _____

	A	B	C	D	E	F	G	H	I	J	K	L
2	6	5	4	3	2	1						
3												
4	7	8	9	10	11	12						
5												
6	18	17	16	15	14	13						
7												
8	19	20	21	22	23	24						
9												
10	30	29	28	27	26	25						
11												
12	31	32	33	34	35	36						
13												

I, Robert L. Wetherell, in a field survey on November 3, 19 97
 do hereby certify that under requirements of P.A. 74, Michigan P.A. of 1970, the corner points mentioned in lines 1 and 2 above were in conformance with regulations and rules therefore as required in the current manual of survey instructions of the United States Department of the Interior Bureau of Land Management or by a decree of a Court of Law and/or that the corner points mentioned in lines 3, 4 and 5 above were in conformance with the rules of the Michigan Board of Land Surveyors or by a Decree of a Court of Law; established, re-established, monumented, re-monumented, recovered, found as expressed below:

NOTE: Not more than 4 corners, all in the same town and range, may be recorded on this certificate.

A. Description of original monument and accessories and/or subsequent restoration:

C-9 - Section corner common to Sections 19, 20, 29 & 30, T17N, R12W, Lake Co., Mi.

1838 - John Hodgson, G.L.O.

#1 - 8" Pine N79°W 14 Links

#2 - 8" Pine S61°E 34 Links

Undated - George Johnson, Co. Sur.

Old field book calls for:

1-1/4" Pipe - 20" Long


B. Description of corner evidence found and/or method applied in restoring or reestablishing corner:

C-9 - Section corner common to Sections 19, 20, 29 & 30, T17N, R12W, Lake Co., Mi.

I found the 1-1/4" pipe, 20" long. I also found a 24" W. Oak to the Southeast with two old blazes, I had no record of this accessory.

Condition of the accessories are as follows: #1 Gone, #2 Gone.

RATIFIED BY THE LAKE CO. PEER REVIEW GROUP
 IN ACCORDANCE WITH P.A. 345
 CHAIRMAN R.L.W.
 DATE 12-10-97

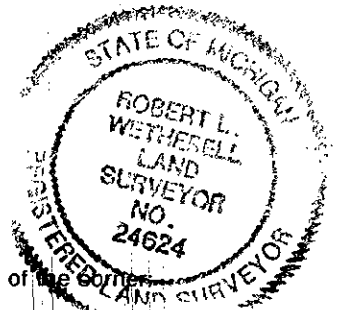

C. Description of monument for corner and accessories established to perpetuate locating the position of the corner:

C-9 - Section corner common to Sections 19, 20, 29 & 30, T17N, R12W, Lake Co., Mi.

I placed a 3/4" x 24" re-bar with Lake County Brass Cap inside the 1-1/4" Pipe, and is accepted as a careful and faithful re-establishment of the position of the original corner.

- 12" W. Oak S88°E 16.14' (60d spike in S. side)
- 10" B. Oak S07°E 40.00' (60d spike in W. side)
- 10" Tw. B. Oak N17°W 66.06' (60d spike in E. side)
- 16" B. Oak (in clump of 5) N62°W 54.53' (60d spike in S. side)

Signed by Robert L. Wetherell

Date 12-12-97

Surveyor's Michigan License No. 24624