

NOV 15 1994

COMMISSION

LAND CORNER RECORDATION CERTIFICATE
Filing Requirement of Act 74, Mich. P.A. 1970

LIBER 003 PAGE 0227

For corners in Lake

(County)	Located In:		Corner Code #
1. Public Land Survey	T 17N	R 12W	D-5
	T	R	
	T	R	
	T	R	
2. Property Controlling in Section	S	T	R
	S	T	R
3. Miscellaneous Property in Sec.	S	T	R
	S	T	R
4. Lot No. _____, Recorded Plat _____			
5. Private Claims _____			

REGISTER OF DEEDS

Register of Deeds

OCT 7 3 46 PM '94

RECORDED
LAKE COUNTY, MI.

Register of Deeds Stamp & File Number

I, Robert L. Wetherell, in a field survey on August 2, 1994, do hereby certify that under requirements of P.A. 74, Michigan P.A. of 1970, the corner points mentioned in lines 1 and 2 above were in conformance with regulations and rules therefore as required in the current manual of survey instructions of the United States Department of the Interior, Bureau of Land Management or by a decree of a Court of Law and/or that the corner points mentioned in lines 3, 4 and 5 above were in conformance with the rules of the Michigan Board of Land Surveyors or by a Decree of a Court of Law; established, re-established, monumented, re-monumented, recovered; found as expressed below:

NOTE: Not more than 4 corners, all in the same town and range, may be recorded on this certificate.

A. Description of original monument and accessories and/or subsequent restoration:

D-5 - (1/4 Corner common To Sections 8 and 17, T17N, R12W, Lake Co., Mi.)

1837 - John Hodgson, G.L.O.

#1 - 24" Pine South 13 Links

#2 - 20" Pine N28°W 56 Links

1911-1914 - George Johnson, Co. Surveyor

#3 - 14" W. Oak N41°E 16 Links

1941-George Blass, L.S. 5489

Well Point

#4 - 10" Tw. White Oak S56°E 26.75'

#5 - 24" White Oak N19°E 16.50'

#6 - 10" B. Oak S71°W 19.92'

(SEE OVER FOR CONTINUATION OF "A")

B. Description of corner evidence found and/or method applied in restoring or reestablishing corner:

D-5 - (1/4 Corner common To Sections 8 and 17, T17N, R12W, Lake Co., Mi.)

I found 5" x 60" Concrete Monument set by Griffin in 1976, condition of accessores are as follows: #1 Gone, #2 Found remains of stump, #3 Found in good condition, #4 Found in good condition, #5 Found in good condition, #6 Gone, #7 Found in good condition, #8 Found in good condition, #9 Found in good condition, #10 Found in good condition, #11 Found in good condition, #12 Found in good condition, #13 Gone.

C. Description of monument for corner and accessories established to perpetuate locating the position of the corner:

D-5 - (1/4 Corner common To Sections 8 and 17, T17N, R12W, Lake Co., Mi.)

I accepted the 5" x 60" Concrete Monument as a substantial marker for the corner and a careful and faithful perpetuation of the position of the original corner.

12" Tw. White Oak S56°E 27.24' (60d spike in S.W. side of tree) (#11)

18" W. Oak N19°E 17.32' (60d spike in S.E. side of tree) (#5)

9" B. Oak N44°W 30.96' (Boat spike in N.E. side of tree) (#9)

10" W. Oak S8°E 48.36' (60d spike in E. side of tree)


Signed by Robert L. Wetherell
LS 24624

Date October 4, 1994

Surveyor's Michigan License No. _____

RATIFIED BY THE LAKE CO. PEER REVIEW GROUP
IN ACCORDANCE WITH P.A. 345
CHAIRMAN R.F.W.

	A	B	C	D	E	F	G	H	I	J	K	L	M
2	6	5	4	3	2	1							
3													
4	7	8	9	10	11	12							
5													
6	18	17	16	15	14	13							
7													
8	19	20	21	22	23	24							
9													
10	30	29	28	27	26	25							
11													
12	31	32	33	34	35	36							
13													

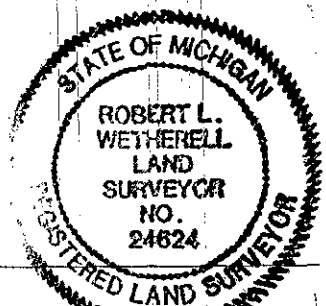

CONTINUATION OF "A" - DESCRIPTION OF ORIGINAL MONUMENT AND ACCESSORIES AND/OR SUBSEQUENT RESTORATION.

1976 - Robert A. Griffin, L.S. 13584

Replaced well point with 5"x60" Concrete Monument

- #7 - 12" W. Oak N19°E 17.32
- #8 - 12" Tw. W. Oak S56°E 27.24' (#4)
- #9 - 7" B. Oak N44°W 30.96'
- #10 - 4"x7' Post North 1.5'

L.C.R.C. - L. 02, Page 379.

1979 - Clint Cole, L.S. 17615

Concrete Monument

- #11 - 10" Tw. W. Oak S56°E 27.24' (#4)
- #12 - 24" W. Oak N19°E 16.50' (#5)
- #13 - 10" B. Oak S71°W 19.92' (#6)

SLAVEY &
REMONUMENTATION

NOV 15 1994

COMMISSION