

MAY 16 1997

LAND CORNER RECORDATION CERTIFICATE
Filing Requirement of Act 74, Mich. P.A. 1970

LIBER 003 PAGE 0359

For corners in COMMISSION

Lake (County)	Located In:		Corner Code ##
1. Public Land Survey	T 17N	R 12W	G-11
	T	R	
	T	R	
	T	R	
2. Property Controlling in Section	S	T	R
	S	T	R
3. Miscellaneous Property in Sec.	S	T	R
	S	T	R
4. Lot No. _____, Recorded Plat _____			
5. Private Claims _____			

REGISTERED
 LAKE COUNTY, MI.
 SEP 12 3 10 PM '96
 REGISTER OF DEEDS
 Register of Deeds Stamp & File Number

I, Robert L. Wetherell, in a field survey on August 7, 1996, do hereby certify that under requirements of P.A. 74, Michigan P.A. of 1970, the corner points mentioned in lines 1 and 2 above were in conformance with regulations and rules therefore as required in the current manual of survey instructions of the United States Department of the Interior, Bureau of Land Management or by a decree of a Court of Law and/or that the corner points mentioned in lines 3, 4 and 5 above were in conformance with the rules of the Michigan Board of Land Surveyors or by a Decree of a Court of Law; established, re-established, monumented, re-monumented, recovered, found as expressed below:

NOTE: Not more than 4 corners, all in the same town and range, may be recorded on this certificate.

A. Description of original monument and accessories and/or subsequent restoration:

G-11 - Section corner common to Sections 27, 28, 33 & 34, T17N, R12W, Yates Twp., Lake Co., Mi.

1838 - J. Hodgson, G.L.O.
 #1 - 8" Pine S67°E 10 Links
 #2 - 11" Pine N55°W 51 Links

Undated - George Johnson (1920's m/L)
 "Iron"
 #3 - 9" B. Oak N18°W 62.0'

Undated U.S.F.S.
 #4 - Pine Stump N54°W 54.1'
 #5 - Oak N16°W 64.5'
 #6 - B. Oak S58°W 59.6'

(See over for continuation of "A")

B. Description of corner evidence found and/or method applied in restoring or reestablishing corner:

G-11 - Section corner common to Sections 27, 28, 33 & 34, T17N, R12W, Yates Twp., Lake Co., Mi.

I found the U.S.F.S. Concrete Monument in the intersection of dirt roads East, West and North and 15 feet West of centerline of dirt road South.

Condition of the accessories are as follows: #1 Gone, #2 Gone, #3 Gone, #4 Gone, #5 Gone, #6 Gone, #7 Found in good condition, #8 Found stump, #9 Found in good condition, #10 Found in good condition, #11 Found in good condition.

ATTESTED BY THE LAKE CO. PEER REVIEW GROUP
 IN ACCORDANCE WITH P.A. 345
 CHAIRMAN

DATE - 8-27-96
R.L.W.

C. Description of monument for corner and accessories established to perpetuate locating the position of the corner:

G-11 - Section corner common to Sections 27, 28, 33 & 34, T17N, R12W, Yates Twp., Lake Co., Mi.


I accepted the U.S.F.S. Concrete Monument as a substantial marker for the corner, and is accepted as a careful and faithful re-establishment of the position of the original corner.

- 9" R. Pine S35°W 59.03' (dock spike in W. side) #10
- 14" R. Pine S51°E 81.12' (dock spike in Easterly side) #9
- 20" B. Oak N6°W 90.20' (60d spike in W. side)
- 7" R. Pine N36°E 75.55' (60d spike in N.W. side)

Signed by Robert L. Wetherell

Date August 28, 1996

Surveyor's Michigan License No. 24624

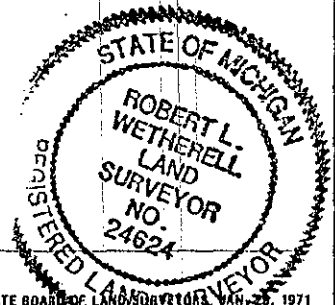

CONTINUATION OF "A" - DESCRIPTION OF ORIGINAL MONUMENT AND ACCESSORIES AND/OR SUBSEQUENT RESTORATION:

1952 - George Blass, LS 5489

"Found remains of rotted wood stake
from old witnesses"

Replaced with 1/2" pipe

#7 - 13" B. Oak N17°W 54.90'

#8 - 11" B. Oak N50°E 103.80'

1974 - Robert Griffin, LS 13584

L.C.R.C. - Liber 2, Page 196

Replaced pipe with U.S.F.S. Concrete Monument

#9 - 6" R. Pine S51°E 81.12'

#10 - 5" R. Pine S35°W 59.03'

#11 - 4" Post S45°W 46.73'