

FEB 18 1994 LAKE COUNTY REMONUMENTATION  
LAND CORNER RECORDATION CERTIFICATE  
Filing Requirement of Act 74, Mich. P.A. 1970

Recorder H. Dechow  
REGISTER OF DEEDS

For corners in

Lake (County)	Located In:	Corner Code #
1. Public Land Survey	T 17 N R 12 W	G-13
	T R	
	T R	
	T R	
2. Property Controlling in Section	S T R	
	S T R	
3. Miscellaneous Property in Sec.	S T R	
	S T R	

Register of Deeds Stamp & File Number

- 4. Lot No. \_\_\_\_\_, Recorded Plat \_\_\_\_\_
- 5. Private Claims \_\_\_\_\_

	A	B	C	D	E	F	G	H	I	J	K	L	M
2	6	5	4	3	2	1							
3													
4	7	8	9	10	11	12							
5													
6	18	17	16	15	14	13							
7													
8	19	20	21	22	23	24							
9													
10	30	29	28	27	26	25							
11													
12	31	32	33	34	35	36							
13													

I, Robert L. Wetherell, in a field survey on November 4, 1993, do hereby certify that under requirements of P.A. 74, Michigan P.A. of 1970, the corner points mentioned in lines 1 and 2 above were in conformance with regulations and rules therefore as required in the current manual of survey instructions of the United States Department of the Interior, Bureau of Land Management or by a decree of a Court of Law and/or that the corner points mentioned in lines 3, 4 and 5 above were in conformance with the rules of the Michigan Board of Land Surveyors or by a Decree of a Court of Law; established, re-established, monumented, re-monumented, recovered, found as expressed below:

**NOTE: Not more than 4 corners, all in the same town and range, may be recorded on this certificate.**

A. Description of original monument and accessories and/or subsequent restoration:  
G-13 - (Section corner, Sections 33 & 34, T17N, R12W, on the County Line)

1837 - John Hodgson, D.S., G.L.O.  
Set Wood Post  
#1 8" Aspen N62°W 22 Links  
#2 9" Aspen N83°E 15 Links

1952 - George Blass, LS 5489  
Found 1-1/4" Pipe with smaller pipe inside.  
#6 12" B. Oak S37°E 24.00'  
#7 12" B. Oak S54°W 26.65'  
#5 8" R. pine N10°E 50.00'

1974 - Robert Griffin, LS 13584  
Replaced 1-1/4" pipe with 5" x 60" conc. mon., L.C.R.C. L.02-P.208  
#9 4" R. Pine S22°W 30.89'  
#10 15" B. Oak S54°W 27.17'  
#11 12" R. Pine N74°W 75.02'  
#12 4" x 7" Pine Post North 1.6'  
#8 11" R. pine N10°E 50.32'

B. Description of corner evidence found and/or method applied in restoring or reestablishing corner:

G-13 - (Section corner, Sections 33 & 34, T17N, R12W, on the County Line)

I found Griffin's concrete monument - NOTE: Brass Cap had been broken off the top of monument. I accepted the position for section corner. Condition of witnesses are: #1 Gone, #2 Gone, #3 Gone, #4 Gone, #5 Found in good condition, #6 Found Stump, #7 Found in good condition, #8 Found in good condition, #9 Found in good condition, #10 Found in good condition, #11 Found in good condition, #12 Down in poor condition.

NOTE: 1-1/4" Pipe is consistent with George Johnson's corner.

C. Description of monument for corner and accessories established to perpetuate locating the position of the corner:


G-13 - (Section corner, Sections 33 & 34, T17N, R12W, on the County Line)

Replaced 5"x60" Concrete Monument with 3/4" x 24" Re-rod, with Lake County Brass Cap, and is accepted as a careful and faithful re-establishment of the position of the original corner.

- 14" R. Pine N10°E 50.23' (60d nail in East side of tree) (#5)
- 7" R. Pine S22°W 30.89' (60d nail in SW side of tree) (#9)
- 18" B. Oak S54°W 27.17' (60d nail in SE side of tree) (#7)
- 15" R. Pine N74°W 75.02' (60d nail in SW side of tree) (#11)

Signed by Robert L. Wetherell  
LS 24624

Date 12-13-93

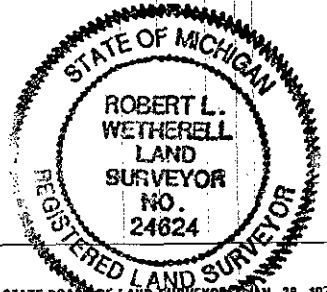

Surveyor's Michigan License No. \_\_\_\_\_

Approved by Peer Review Group December 6, 1993  
Robert L. Wetherell, County Representative R.L.W.