SURVEY & REMONUMENTATION

FEB 1 8 1994

RECORDED
LAKE COUNTY, MI.
LIBER 003 PAGE 0202
DEC 13 3 42 PM '93

REGISTER OF DEEDS

LAKE COUNTY REMONUMENTATION

LAND CORNER RECORDATION CERTIFICATE

Filing Requirement of Act 74, Mich. P.A. 1970

For corners in Lake (County)

	Located In:	Corner Code #
1. Public Land Survey	T 17N R 12W	I-13
	T ___ R ___	
	T ___ R ___	
	T ___ R ___	
2. Property Controlling	S ___ T ___ R ___	
in Section	S ___ T ___ R ___	
3. Miscellaneous	S ___ T ___ R ___	
Property in Sec.	S ___ T ___ R ___	

Register of Deeds Stamp & File Number

4. Lot No. _____ , Recorded Plat _____
5. Private Claims _____

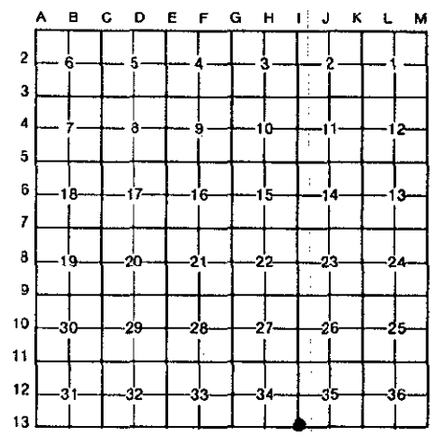

I, Robert L. Wetherell, in a field survey on November 4, 19 93, do hereby certify that under requirements of P.A. 74, Michigan P.A. of 1970, the corner points mentioned in lines 1 and 2 above were in conformance with regulations and rules therefore as required in the current manual of survey instructions of the United States Department of the Interior, Bureau of Land Management or by a decree of a Court of Law and/or that the corner points mentioned in lines 3, 4 and 5 above were in conformance with the rules of the Michigan Board of Land Surveyors or by a Decree of a Court of Law; established, re-established, monumented, re-monumented, recovered, found as expressed below:

NOTE: Not more than 4 corners, all in the same town and range, may be recorded on this certificate.

A. Description of original monument and accessories and/or subsequent restoration:

I-13 - (Section corner common to Sections 34 and 35, T17N, R12W, on the County Line)

1837 - John Hodgson, D.S., G.L.O.
Placed Wood Stake
#1 10" Hemlock N41°E 25 Links
#2 10" Maple N74°W 21 Links

George Johnson, County Surveyor
Undated Survey
#3 26" Oak N54°W 29.70' ?
#4 Pine Stump N54°W 29.70 ?

1952 - George Blass, LS 5489
Found 1" Iron Pipe & Cedar Stake
#5 20" W. Pine N55°E 40.55'
#6 10" Cedar S40°E 29.10'
#7 16" W. Pine N65°W 31.60'

B. Description of corner evidence found and/or method applied in restoring or reestablishing corner:

I-13 - (Section corner common to Sections 34 and 35, T17N, R12W, on the County Line)

I found 1" Iron Pipe and Cedar Stake near fence corner and accepted as the true position of the corner. Condition of the witnesses are: #1 gone, #2 Gone, #3 Gone, #4 Gone, #5 Found in good condition, #6 Found in good condition, #7 Tree blown down.

NOTE: The 1" Pipe found by Surveyor Blass is consistant with the type of monument George Johnson used.

C. Description of monument for corner and accessories established to perpetuate locating the position of the corner:

I-13 - (Section corner common to Sections 34 and 35, T17N, R12W, on the County Line)

I set 3/4" x 24" Re-rod with Lake County Brass cap inside existing 1" Iron Pipe and is accepted as a careful and faithful re-establishment of the position of the original corner.

10" Cedar S40°E 29.40' (60d nail in SW side of tree) (#6)
18" W. Pine S39°W 31.39' (60d nail in NW side of tree)
8" R. Maple N57°W 45.52' (60d nail in NE side of tree)
9" R. Maple N32°E 31.78' (60d nail in SE side of tree)

STATE OF MICHIGAN
ROBERT L. WETHERELL
LAND SURVEYOR
NO. 24624
REGISTERED LAND SURVEYOR

Signed by Robert L Wetherell LS. 24624 Date 12-13-93

Surveyor's Michigan License No. _____

Approved by Peer Review Group December 6, 1993
Robert L. Wetherell, County Representative R.L.W.

FORM APPROVED BY MICHIGAN STATE BOARD OF LAND SURVEYORS, JAN. 28, 1971
REVISED MAY 14, 1975
REVISED JAN., 1983