

**SURVEY & REMONUMENTATION**

**AUG 31 1999**

**LAND CORNER RECORDATION CERTIFICATE**

FILING REQUIREMENT OF ACT 74, Mich. P.A. 1970

RECORDED  
LAKE COUNTY, MI.

LIBER 004 PAGE 0188

JUL 23 3 02 PM '99

*Annalisa H. Richard*

REGISTER OF DEEDS

**SECTION**

For corners in Lake	Located in:	Corner Code#
1. Public Land Survey	T 17N R12W	K-1
	T R	
	T R	
	T R	
2. Property Controlling in Section	S T R	
	S T R	
3. Miscellaneous Property in Sec.	S T R	
	S T R	
4. Lot No. _____ Recorded Plat _____		
5. Private Claims _____		

Register of Deeds Stamp & File Number

I, **Robert L. Wetherell**, in a field survey on June 2, 1999, do hereby certify that under requirements of P.A. 74, Michigan P.A. of 1970, the corner points mentioned in lines 1 and 2 above were in conformance with regulations and rules therefore as required in the current manual of survey instructions of the United States Department of the Interior, Bureau of Land Management or by decree of a Court of Law and/or that the corner points mentioned in lines 3, 4, and 5 above were in conformance with the rules of the Michigan Board of Land Surveyors or by a Decree Of a Court of Law; established, re-established, monumented, re-monumented, recovered, found as expressed below:

	A	B	C	D	E	F	G	H	I	J	K	L	M
1													
2	6	5	4	3	2	1							
3													
4	7	8	9	10	11	12							
5													
6	18	17	16	15	14	13							
7													
8	19	20	21	22	23	24							
9													
10	30	29	28	27	26	25							
11													
12	31	32	33	34	35	36							
13													

**K-1 - Section corner common to Sections 1 & 2, T17N, R12W**

**A. Description of original monument and accessories and/or subsequent restoration:**

**1838 - J. Hodgson, G.L.O.**

#1 - 20" Pine S67°E 10 Links  
#2 - 20" Pine S29°W 44 Links  
Corner Sec. 35 & 36(T18N, R12W)  
West 80 Links

**1965 - R.A. Griffin, LS 13584**

L.C.R.C. Liber 02, Pg. 268  
Set 5" Square Concrete Monument  
#3 - 4" R. Pine S88°E 36.69'  
#4 - 4" R. Pine S34°E 23.37'  
#5 - Concrete Monument West 52.80'  
#6 - 5" x 7" Post North 2.0'

**1974 - E. McCombs (Consumers Power)**

"Found corner"

**1996 - R. L. Wetherell, LS 24624**

Surveyed of N.E. 1/4-N.E. 1/4, Sec. 2  
(survey File No. 7771-96)  
No witnesses shown.

**B. Description of corner evidence found and/or method applied in restoring of reestablishing corner:**

I found Griffin's 5" Square Concrete Monument 53 feet more or less East of North and South road.


Condition of the accessories are as follows: #1 Gone, #2 Gone, #3 Found in good condition, #4 Found in good condition, #5 Found in good condition #6 found in poor condition.

**C. Description of monument for corner and accessories established to perpetuate locating the position of the corner:**

I accepted the 5" Square Concrete Monument as a substantial marker for the corner, and is accepted as a careful and faithful re-establishment of the original corner.

10" R. Pine S83°E 36.72' (dock spike in S. side) #3  
10" R. Pine S29°E 23.45' (dock spike in E. side) #4  
6" W. Pine N41°W 3.33' (60d spike in N.E. side)  
5" Concrete Monument West 52.80' (Sec. corner common to Section 35 & 36, T18N, R12W)

RATIFIED BY THE LAKE CO. PEER REVIEW GROUP  
IN ACCORDANCE WITH P.A. 345  
CHAIRMAN *R.L.W.*  
DATE 7-20-99

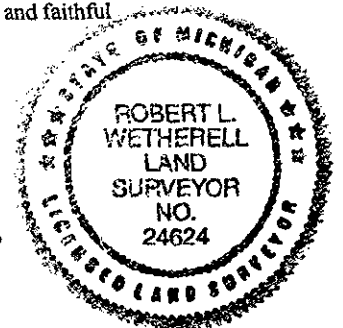

Signed by

*Robert L. Wetherell*

Date July 21, 1999

Surveyor's Michigan License No. 24624