

**SURVEY & REMONUMENTATION**

**AUG 31 1999**

**LAND CORNER RECORDATION CERTIFICATE**

FILING REQUIREMENT OF ACT 74, Mich. P.A. 1970

RECORDED  
LAKE COUNTY, MI.

SECTION

LIBER 004 PAGE 0190

JUL 23 3 03 PM '99

*Richard H. Dechow*  
REGISTER OF DEEDS

Register of Deeds Stamp & File Number

For corners in Lake	Located in:	Corner Code#
1. Public Land Survey	T 17N R 12W	L-3
	T R	
	T R	
	T R	
2. Property Controlling in Section	T R	
	S T R	
3. Miscellaneous Property in Sec.	S T R	
	S T R	
4. Lot No. _____ Recorded Plat		
5. Private Claims		

	A	B	C	D	E	F	G	H	I	J	K	L	M
1													
2	6	5	4	3	2	1							
3													
4	7	8	9	10	11	12							
5													
6	18	17	16	15	14	13							
7													
8	19	20	21	22	23	24							
9													
10	30	29	28	27	26	25							
11													
12	31	32	33	34	35	36							
13													

I, Robert L. Wetherell, in a field survey on January 28, 1999, do hereby certify that under requirements of P.A. 74, Michigan P.A. of 1970, the corner points mentioned in lines 1 and 2 above were in conformance with regulations and rules therefore as required in the current manual of survey instructions of the United States Department of the Interior, Bureau of Land Management or by decree of a Court of Law and/or that the corner points mentioned in lines 3, 4, and 5 above were in conformance with the rules of the Michigan Board of Land Surveyors or by a Decree Of a Court of Law; established, re-established, monumented, re-monumented, recovered, found as expressed below:

**L-3 - 1/4 Corner common to Sections 1 & 12, T17N, R12W**

**A. Description of original monument and accessories and/or subsequent restoration:**

1838 - J. Hodgson, G.L.O.  
#1 - 7" Birch N8°W 38 Links  
#2 - 9" Birch S66°E 21 Links

G.H. Johnson, Co. Sur. (1920's)  
"Iron"  
#5 - 10" W. Oak N29°30'E 36.6'

1979 - R.L. Wetherell, LS 24624  
Lakestate File No. 3249-79  
Same witnesses as G.H. Johnson

UNKNOWN ORIGIN  
#3 - 20" Pine N15°W 30'  
#4 - 7" Beech S47°E 9'

1973 - C. Cole, LS 17615  
Section subdivision of Section 1,  
shows distance of 2622.77' East and  
2605.94' West

**B. Description of corner evidence found and/or method applied in restoring or reestablishing corner:**

I found a 1-1/4" x 12" shaft threaded on both ends with concrete around it.


Condition of the accessories are as follows: #1 Gone, #2 Gone, #3 Found Stump, #4 Gone, #5 Found Stump.

**C. Description of monument for corner and accessories established to perpetuate locating the position of the corner:**

I replaced the shaft with a 3/4" x 24" re-bar with Lake County Remon Cap and is accepted as a careful and faithful re-establishment of the position of the original corner.

16" B. Oak S79°E 24.28' (Found blaze on tree - set 60d spike in S. side)  
7" Maple S29°E 32.60' (60d spike in W. side)  
11" W. Oak S55°W 26.56' (60d spike in S.E. side)  
8" W. Oak N70°W 56.33' (60d spike in S. side)

SEARCHED BY \_\_\_\_\_ INDEXED BY \_\_\_\_\_  
SERIALIZED \_\_\_\_\_ FILED BY \_\_\_\_\_  
DATE 7-20-99

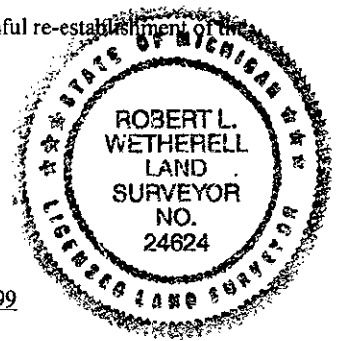

Signed by Robert L. Wetherell

Date July 21, 1999

Surveyor's Michigan License No. 24624