

MAY 16 1997

LAND CORNER RECORDATION CERTIFICATE
Filing Requirement of Act 74, Mich. P.A. 1970

LIBER 003 PAGE 0352

For corners in

Lake (County)	Located In:	Corner Code #/
1. Public Land Survey	T 17N R 12W	M-5
	T 17N R 11W	A-5
	T R	
	T R	
	T R	
2. Property Controlling in Section	S T R	
	S T R	
3. Miscellaneous Property in Sec.	S T R	
	S T R	

RECORDED
LAKE COUNTY, MI.
SEP 12 3 07 PM '96
REGISTER OF DEEDS
Register of Deeds Stamp & File Number

- 4. Lot No. _____, Recorded Plat _____
- 5. Private Claims _____

	A	B	C	D	E	F	G	H	I	J	K	L	M
2	6	5	4	3	2	1							
3													
4	7	8	9	10	11	12							
5													
6	18	17	16	15	14	13							
7													
8	19	20	21	22	23	24							
9													
10	30	29	28	27	26	25							
11													
12	31	32	33	34	35	36							
13													

I, Robert L. Wetherell, in a field survey on August 7, 1996, do hereby certify that under requirements of P.A. 74, Michigan P.A. of 1970, the corner points mentioned in lines 1 and 2 above were in conformance with regulations and rules therefore as required in the current manual of survey instructions of the United States Department of the Interior, Bureau of Land Management or by a decree of a Court of Law and/or that the corner points mentioned in lines 3, 4 and 5 above were in conformance with the rules of the Michigan Board of Land Surveyors or by a Decree of a Court of Law; established, re-established, monumented, re-monumented, recovered, found as expressed below:

NOTE: Not more than 4 corners, all in the same town and range, may be recorded on this certificate.

A. Description of original monument and accessories and/or subsequent restoration:

M-5 & A-5 - Section corner common to Sections 12 & 13, T17N, R12W AND Sections 7 & 18, T17N, R11W, Lake Co., Mi.

- | | | |
|-------------------------------------|--|--|
| <u>1837 - John Hodgson, G.L.O.</u> | <u>Undated County Survey Records (prior to 1916)</u> | <u>1916 - George Johnson, Co. Sur.</u> |
| <u>#1 - 8" Aspen S57°W 15 Links</u> | <u>Iron Pipe/Stones. Corner N41°E, 67 Chains of</u> | <u>Old Stake with stones,</u> |
| <u>#2 - 21" Pine N34°W 25 Links</u> | <u>U.S.F.S. Post "Set by County Surveyor at</u> | <u>Set well point</u> |
| | <u>Location identified by old settler".</u> | <u>#3 - 14" B. Oak N18°E 80.8'</u> |
| | | <u>#4 - 16" W. Oak N28°W 55.0'</u> |

(See over for continuation of "A")

B. Description of corner evidence found and/or method applied in restoring or reestablishing corner:

M-5 & A-5 - Section corner common to Sections 12 & 13, T17N, R12W AND Sections 7 & 18, T17N, R11W, Lake Co., Mi.

I found a 5" x 36" concrete monument at the intersection of roads North, South, East and West. Checked well with accessories found. Condition of accessories are as follows: #1 gone, #2 gone, #3 Gone, #4 Found stub, #5 Gone, #6 Found in good condition, (45'), #7 Found in good condition, #8 Found in good condition, #9 Found in good condition.

I set a 60d spike over the monument at road surface.

RATIFIED BY THE LAKE CO. PEER REVIEW GROUP
IN ACCORDANCE WITH P.A. 345

CHAIRMAN

DATE 8-27-96

[Signature]

C. Description of monument for corner and accessories established to perpetuate locating the position of the corner:

M-5 & A-5 - Section corner common to Sections 12 & 13, T17N, R12W AND Sections 7 & 18, T17N, R11W, Lake Co., Mi.


I accepted the U.S.F.S. 5" x 36" monument as a substantial marker for the corner, and is accepted as a careful and faithful re-establishment of the position of the original corner.

- 12" J. Pine N49°E 137.33' (found nail in S.E. side, tree blazed)
- 8" W. Oak N56°W 63.56'
- S.W. leg of steel tower N14°E 231.06' (#7)
- N.W. leg of steel tower S10°E 207.15' (#8)
- Post N42°W 46.68' (#9)

Signed by Robert L. Wetherell

Date August 8, 1996

Surveyor's Michigan License No. 24624

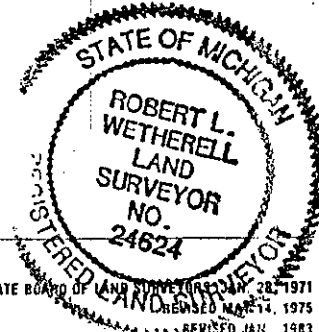

CONTINUATION OF "A" - DESCRIPTION OF ORIGINAL MONUMENT AND ACCESSORIES AND/OR SUBSEQUENT RESTORATION:1952 - Maurice M. Buck, C.E.

Iron Stake and Stones

#4 - N.W. 56.0' - 30" W. Oak

#5 - N.E. 122.2' - 10" J. Pine

#6 - 46' East to centerline
steel tower line1971 - George Blass, LS 5489

Set "T" Iron from 1952

M. Buck's witnesses

Accessories same as Buck's

1974 - Robert A. Griffin, LS 13584

Replaced "T" iron with U.S.F.S.

5' x 36" Concrete Monument

7 - S.W. leg of Tower N12°E 231.15'

8 - N.W. leg of Tower S10°E 207.23'

9 - 4" x 7' Post N45°W 46.68'