

JAN 12 1996

COMMISSION

LAND CORNER RECORDATION CERTIFICATE
Filing Requirement of Act 74, Mich. P.A. 1970

LIBER 003 PAGE 0302

Corner corners in

Lake _____ (County) Located In: _____ Corner Code # _____

Public Land Survey

T 17N	R 11W	A-10
T 17N	R 12W	M-10
T _____	R _____	_____
T _____	R _____	_____
Property Controlling in Section S _____	T _____	R _____
Miscellaneous S _____	T _____	R _____
Property in Sec. S _____	T _____	R _____

RECORDED
LAKE COUNTY, MI.
SEP 5 3 04 PM '95
REGISTER OF DEEDS
Register of Deeds Stamp & File Number

Lot No. _____, Recorded Plat _____
Private Claims _____

Robert L. Wetherell, in a field survey on August 21, 1995, hereby certify that under requirements of P.A. 74, Michigan P.A. of 1970, the corner points mentioned in lines 1 and 2 above were in conformance with regulations and rules therefore as required in the current manual of survey instructions of the United States Department of the Interior, Bureau of Land Management or by a decree of a Court of Law and/or that the corner points mentioned in lines 3, 4 and 5 above were in conformance with the rules of the Michigan Board of Land Surveyors or by a Decree of a Court of Law; established, re-established, monumented, re-monumented, recovered, found as expressed below:

	A	B	C	D	E	F	G	H	I	J	K	L	M
2	6	5	4	3	2	1							
3													
4	7	8	9	10	11	12							
5													
6	18	17	16	15	14	13							
7													
8	19	20	21	22	23	24							
9													
10	30	29	28	27	26	25							
11													
12	31	32	33	34	35	36							
13													

NOTE: Not more than 4 corners, all in the same town and range, may be recorded on this certificate.

Description of original monument and accessories and/or subsequent restoration:

A-10 & M-10 - 1/4 corner common to Section 30, T17N, R11W AND Section 25, T17N, R12W, Lake Co., Mi.

- | | | |
|--|--|--|
| 1837 - John Hodgson, G.L.O.
#1 - 22" Pine S52°W 8 Links
#2 - 14" Pine N47°W 10 Links
1916 - George Johnson, Co. Surveyor
1" Gas Pipe
#3 - 5" W. Oak N49°E 30'
#4 - 6" B. Oak N20°W 32.5' | 1973 - Clinton E. Cole, LS 17615
Survey recorded in Liber 01, Pg. 233
Found 1" Iron Pipe
#5 - 6" Maple N70°W 61.43'
#6 - 10" W. Oak S54°W 66.12'
#7 - 7" R. Oak S62°E 117.98' | 1976 - Robert A. Griffin, LS 13584
Replaced 1" Iron Pipe with 5" x 60" Concrete Monument.
L.C.R.C. - Liber 02, Pg. 183.
#5 - 6" Maple N70°W 61.43'
#6 - 10" W. Oak S54°W 66.12'
#7 - 7" R. Oak S62°E 117.98'
#8 - 1/2" Re-bar N45°E 46.72' |
|--|--|--|

Description of corner evidence found and/or method applied in restoring or reestablishing corner:

A-10 & M-10 - 1/4 corner common to Section 30, T17N, R11W AND Section 25, T17N, R12W, Lake Co., Mi.


I found 5" Concrete Monument 6 feet more or less North of East and West dirt road and 5 feet West of North and South dirt road. I found accessories 5 thru 8 in good condition. I did not recover accessories 1 thru 4 inclusive.

Description of monument for corner and accessories established to perpetuate locating the position of the corner:

A-10 & M-10 - 1/4 corner common to Section 30, T17N, R11W AND Section 25, T17N, R12W, Lake Co., Mi.

I accepted the 5" Concrete Monument, as a substantial monument for the corner, and is accepted as a corner and re-establishment of the position of the original corner.

- 8" Maple N64°W 61.43' (60d spike in N. side) #5
- 12" W. Oak S54°W 66.12" (60d spike in N. side) #6
- 11" R. Oak S62°E 118.07' (60d spike in S. side) #7
- S.W. Leg of steel tower N14°E 177.92'

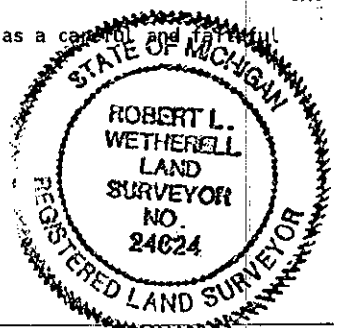

Signed by Robert L. Wetherell Date August 29, 1995

Surveyor's Michigan License No. 24624
 RATIFIED BY THE LAKE CO. PEER REVIEW GROUP
 IN ACCORDANCE WITH P.A. 345
 CHAIRMAN R.L.W.
 DATE 8.29.95