

JAN 12 1996

COMMISSION

LAND CORNER RECORDATION CERTIFICATE
 Filing Requirement of Act 74, Mich. P.A. 1970

LIBER 003 PAGE 0303

corners in

Lake _____ (County)	Located In:	Corner Code ##
Public Land Survey	T 17N R 11W A-11 T 17N R 12W M-11	✓
Property Controlling in Section	S _____ T _____ R _____	
Miscellaneous	S _____ T _____ R _____	
Property in Sec.	S _____ T _____ R _____	

REGISTERED
 LAKE COUNTY, MI.
 SEP 5 3 04 PM '95
 REGISTER OF DEEDS
James M. [Signature]

Register of Deeds Stamp & File Number

Lot No. _____, Recorded Plat _____
 Private Claims _____

Robert L. Wetherell, in a field survey on August 21, 1995,

hereby certify that under requirements of P.A. 74, Michigan P.A. of 1970, the corner points mentioned in lines 1 and 2 above were in conformance with regulations and rules therefore as required in the current manual of survey instructions of the United States Department of the Interior, Bureau of Land Management or by a decree of a Court of Law and/or that the corner points mentioned in lines 3, 4 and 5 above were in conformance with the rules of the Michigan Board of Land Surveyors or by a Decree of a Court of Law; established, re-established, monumented, re-monumented, recovered, found as expressed below:

NOTE: Not more than 4 corners, all in the same town and range, may be recorded on this certificate.

A	B	C	D	E	F	G	H	I	J	K	L	M
2	6	5	4	3	2	1						
3												
4	7	8	9	10	11	12						
5												
6	18	17	16	15	14	13						
7												
8	19	20	21	22	23	24						
9												
10	30	29	28	27	26	25						
11												
12	31	32	33	34	35	36						
13												

Description of original monument and accessories and/or subsequent restoration:

A-11 & M-11 - Section corner common to Sections 30 & 31, T17N, R11W AND Sections 25 & 36, T17N, R12W, Lake Co., Mi.

1837 - John Hodgson, G.L.O.
 #1 - 28" Pine S79°W 36 Links
 #2 - 8" Aspen N64°W 13 Links

1916 - George Johnson, County Surveyor
 Found one of U.S. Bearing Trees.
 A Mr. Youngs, an old settler verified this position. (set round iron rod)
 #3 - 8" B. Oak N66°30'W 33.6'
 #4 - 8" B. Oak S25°E 51.7'
 (SEE OVER FOR CONTINUATION OF "A")

Undated - George Johnson, Co. Sur.
 3/4" Iron - 20" long
 #5 - 8" B. Oak N69°W 41'
 #6 - 8" B. Oak S18°E 48'

Description of corner evidence found and/or method applied in restoring or reestablishing corner:

A-11 & M-11 - Section corner common to Sections 30 & 31, T17N, R11W AND Sections 25 & 36, T17N, R12W, Lake Co., Mi.

I found a 3/4" x 20" Iron Rod with collar on top. With old wood stake along side. Corner is 5 feet west of the center of dirt road.

Condition of the accessories are as follows: #1 Gone, #2 Gone, #3 Gone, #4 Gone, #5 Found in good condition, #6 Found in good condition, #7 Found in good condition, #8 Found in good condition, #9 Found in good condition, #10 Found in good condition.

Description of monument for corner and accessories established to perpetuate locating the position of the corner:


A-11 & M-11 - Section corner common to Sections 30 & 31, T17N, R11W AND Sections 25 & 36, T17N, R12W, Lake Co., Mi.

I replaced the 3/4" Iron with a 3/4" x 24" re-bar with Lake County Brass Cap, and is accepted as a careful and faithful perpetuation of the position of the original corner.

- 10" W. Oak S54°W 61.33' (60d spike in S.E. side) #7
- 10" W. Oak N60°W 69.42' (60d spike in N. side) #8
- 11" W. Oak S66°E 123.96' (60d spike in N. side) #10
- S.W. of Tower N19°E 104.60' - #9

Signed by Robert L. Wetherell Date August 29, 1995
 24624

Surveyor's Michigan License No. _____
 RATIFIED BY THE LAKE CO. PEER REVIEW GROUP
 IN ACCORDANCE WITH P.A. 345
 CHAIRMAN G. J. W.
 DATE 8-29-95

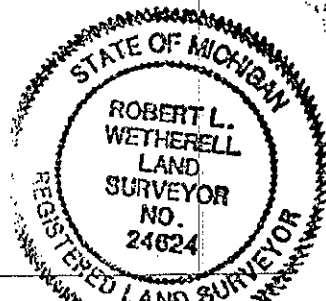

JAN 1 2 1996

COMMISSION

CONTINUATION OF "A" - DESCRIPTION OF ORIGINAL MONUMENT AND ACCESSORIES AND/OR SUBSEQUENT RESTORATION:

1972 - Clinton Cole, LS 17615

Found 3/4" Pipe

S.W. Leg of Tower N19°E 104.6'

#7 - 6" Oak S54°W 61.33'

#8 - 7" Oak N60°W 69.42'

LIBER 003 PAGE 0304

1972 - Robert L. Wetherell, LS 24624

Survey recorded in Liber 02, Page 296.

Reports 3/4" Pipe

Same accessories as 1972 Survey by Clinton Cole

1993 - Robert L. Wetherell, LS 24624

Land Survey recorded in Liber 003- Page 418

#9 - S.W. Leg of Tower N19°E 104.60;

#7 - 10" W. Oak S54°W 61.33'

#8 - 10" W. Oak N60°W 69.42'

#10 - 11" W. Oak S66°E 123.96'