

JAN 25 2001

**LAND CORNER RECORDATION CERTIFICATE**

SECTION \_\_\_\_\_

FILING REQUIREMENT OF ACT 74, Mich. P.A. 1970

For corners in Lake _____	Located in:	Corner Code#
1. Public Land Survey	T 18 N R 13 W	C-13
	T 17 N R 13 W	C-1 ✓
	T R	
	T R	
2. Property Controlling in Section	S T R	
	S T R	
3. Miscellaneous Property in Sec.	S T R	
	S T R	
4. Lot No. _____ Recorded Plat _____		
5. Private Claims _____		

RECORDED  
LAKE COUNTY, MI.  
LIBER 004 PAGE 0269

DEC 8 11 20 AM '00

*Shelley Meyers*

REGISTER OF DEEDS

Register of Deeds Stamp & File Number

	A	B	C	D	E	F	G	H	I	J	K	L	M
1													
2	6	5	4	3	2	1							
3													
4	7	8	9	10	11	12							
5													
6	18	17	16	15	14	13							
7													
8	19	20	21	22	23	24							
9													
10	30	29	28	27	26	25							
11													
12	31	32	33	34	35	36							
13													

I, Robert L. Wetherell, in a field survey on February 22, 2000, do hereby certify that under requirements of P.A. 74, Michigan P.A. of 1970, the corner points mentioned in lines 1 and 2 above were in conformance with regulations and rules therefore as required in the current manual of survey instructions of the United States Department of the Interior, Bureau of Land Management or by decree of a Court of Law and/or that the corner points mentioned in lines 3, 4, and 5 above were in conformance with the rules of the Michigan Board of Land Surveyors or by a Decree of a Court of Law; established, re-established, monumented, re-monumented, recovered, found as expressed below:

C-13 - Corner common to Sections 31 & 32, T18N, R13W &  
C-1 - Corner common to Sections 5 & 6, T17N, R13W

**A. Description of original monument and accessories and/or subsequent restoration:**

1837 - M. Brookfield, G.L.O.

- #1 - 10" W. Pine N56°E 28 Links
- #2 - 9" W. Pine N66°W 12 Links

1920 - 1930 (m/l) - G.H. Johnson, Co. Sur.

- #3 - 10" B. Oak S73°W 47.5'
- #4 - 8" B. Oak N49°30'W 84'
- #5 - 6" W. Oak N22°45'E 71'

1961 - G. Blass, LS 5489

- Found Truck Axle
- #6 - P. Pole N63°W 19.60'
- #7 - 12" Oak N64°E 62.24'
- #8 - 12" Oak S45°E 81.01'
- #9 - 10" Oak S40°W 61.87'

1971 - R.A. Griffin, LS 13584

- L.C.R.C. - Liber 2, Page 26 - Found Axle
- Replaced with 5" Sq. Conc. Post
- #7 - 15" Oak N64°E 62.60'
- #6 - P. Pole N63°W 19.59'
- #10 - 9" W. Oak S84°W 53.75'
- #11 - Pine Post - North 33.02'

1977 - C. Cole, LS 17615

Same witnesses as R. Griffin's, from 1971

**B. Description of corner evidence found and/or method applied in restoring of reestablishing corner:**

I found Griffin's 5" x 60" Square Concrete Monument on North edge of dirt road.

Condition of the accessories are as follows: #1 Gone, #2 Gone, #3 Gone, #4 Found in good condition, #5 gone, #6 Found in good condition, #7 Found in good condition, #8 Gone, #9 Gone, #10 Found in good condition, #11 Found in good condition.


**C. Description of monument for corner and accessories established to perpetuate locating the position of the corner:**

I accepted the 5" Concrete Monument as a substantial marker for the corner and is accepted as a careful and faithful reestablishment of the Position of the original corner.

- 10" W. Oak S40°E 53.75' (60d spike in N.E. side)
- 19" W. Oak N70°E 62.31' (Set spike in N.W. side over Spike & Shiner) #7
- P. Pole N60°W 19.53' (Nail & Shiner S.W. side) #6
- 16" B. Oak N49°W 82.28' (60d in N.E. side) #4
- 12" W. Oak S85°W 53.77' (dock spike in N. side) #10

WITNESSED BY THE LAND SURVEYOR'S PEER REVIEW GROUP  
IN ACCORDANCE WITH P.A. 345

GREENMAN *RJW*  
DATE 12-5-2000

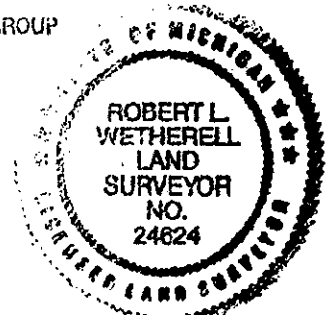

Signed by Robert L. Wetherell

Date December 6, 2000

Surveyor's Michigan License No. 24624