

NOV 21 1997

COMMISSION

LAND CORNER RECORDATION CERTIFICATE
Filing Requirement of Act 74, Mich. P.A. 1970

RECORDED LAKE COUNTY, MI.

LIBER 004 PAGE 0039
SEP 12 10 31 AM '97


For corners in

Table with columns: Lake (County), Located In: (17N, 13W), Corner Code # (C-5). Rows include Public Land Survey, Property Controlling in Section, and Miscellaneous Property in Sec.

Signature of Registrar
REGISTER OF DEEDS

Register of Deeds Stamp & File Number

4. Lot No. Recorded Plat
5. Private Claims

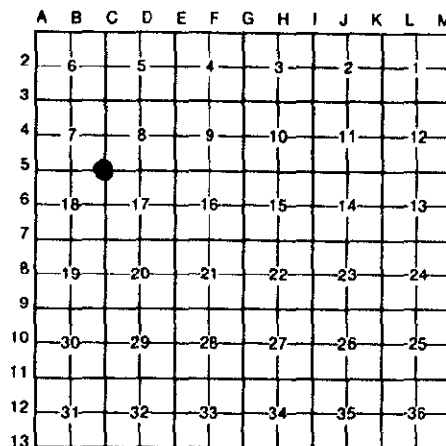

Robert L. Wetherell July 2, 1997

I, Robert L. Wetherell, in a field survey on July 2, 1997, do hereby certify that under requirements of P.A. 74, Michigan P.A. of 1970, the corner points mentioned in lines 1 and 2 above were in conformance with regulations and rules therefore as required in the current manual of survey instructions of the United States Department of the Interior, Bureau of Land Management or by a decree of a Court of Law and/or that the corner points mentioned in lines 3, 4 and 5 above were in conformance with the rules of the Michigan Board of Land Surveyors or by a Decree of a Court of Law; established, re-established, monumented, re-monumented, recovered, found as expressed below:

NOTE: Not more than 4 corners, all in the same town and range, may be recorded on this certificate.

A. Description of original monument and accessories and/or subsequent restoration:

C-5 - Section corner common to Sections 7, 8, 17 & 18, T17N, R13W, Lake Co., Mi.

1838 - J. Hodgson, G.L.O.

#1 - 8" Pine S65°E 22 Links

#2 - 6" Pine N51° 18 Links

1927 - George Johnson, Co. Sur.

Iron Pipe

#3 - 6" W. Oak N66°45'E 10'

#4 - 8" B. Oak S53°45'W 20.2'

1941 - George Blass, LS 5489

Found Iron Pipe

#5 - 12" Tw. W. Oak N23°W 66.87'

#3 - 10" W. Oak N63°E 10.30'

#4 - 16" R. Oak S55°W 19.56'

1991 - Norman Caldwell, LS 12018

U.S.F.S. Contract

L.C.R.C. - Liber 03, Pg. 139.

Found boat spike by Blass.

Set 2" x 30" pipe with Brass Cap.

#6 - 9" W. Pine S50°W 40.00'

#7 - 5" W. Pine N45°W 58.30'

#8 - 9" W. Oak N22°E 42.60'

#9 - Carsonite Post - West 25'

B. Description of corner evidence found and/or method applied in restoring or reestablishing corner:

C-5 - Section corner common to Sections 7, 8, 17 & 18, T17N, R13W, Lake Co., Mi.

I found the U.S.F.S. Pipe Monument at bend in road East and North.

Condition of the accessories are as follows: #1 gone, #2 gone, #3 Found in good condition, #4 found in good condition, #5 Found in good condition, #6 Found in good condition, #7 Found in good condition, #8 Found in good condition, #9 Found in good condition,

RATIFIED BY THE LAKE CO. PEER REVIEW GROUP IN ACCORDANCE WITH P.A. 345

CHAIRMAN R.L.W.
DATE 8-27-97

Description of monument for corner and accessories established to perpetuate locating the position of the corner:

C-5 - Section corner common to Sections 7, 8, 17 & 18, T17N, R13W, Lake Co., Mi.

I accepted the U.S.F.S. Pipe Monument as a substantial marker for the corner, and is accepted as a careful and faithful re-establishment of the position of the original corner.

- 10" W. Oak N26°E 42.56' (60d spike in W. side) #8
10" W. Pine S50°W 40.04' (60d spike in N.W. side) #6
9" W. Oak N67°W 47.44' (dock spike in S. side)
8" W. Pine N39°W 58.24' (60d spike in E. side) #7

Signed by Robert L. Wetherell

Date 8-27-97

Surveyor's Michigan License No. 24624

