

FEB 18 1994

LAKE COUNTY REMONUMENTATION

LAND CORNER RECORDATION CERTIFICATE

Filing Requirement of Act 74, Mich. P.A. 1970

RECORDED LAKE COUNTY, MI.

LIBER 003 PAGE 0204

DEC 13 3 42 PM '93

Recorder H. Dechow

REGISTER OF DEEDS

For corners in

Lake (County)	Located In:	Corner Code #
1. Public Land Survey	T 17 N R 13 W	C-13
	T R	
	T R	
	T R	
2. Property Controlling in Section	S T R	
	S T R	
3. Miscellaneous Property in Sec.	S T R	
	S T R	

Register of Deeds Stamp & File Number

- 4. Lot No: \_\_\_\_\_, Recorded Plat \_\_\_\_\_
- 5. Private Claims \_\_\_\_\_

	A	B	C	D	E	F	G	H	I	J	K	L	M
2	6		5		4		3		2		1		
3													
4	7		8		9		10		11		12		
5													
6	18		17		16		15		14		13		
7													
8	19		20		21		22		23		24		
9													
10	30		29		28		27		26		25		
11													
12	31		32		33		34		35		36		
13													

I, Robert L. Wetherell, in a field survey on November 3, 1993, do hereby certify that under requirements of P.A. 74, Michigan P.A. of 1970, the corner points mentioned in lines 1 and 2 above were in conformance with regulations and rules therefore as required in the current manual of survey instructions of the United States Department of the Interior, Bureau of Land Management or by a decree of a Court of Law and/or that the corner points mentioned in lines 3, 4 and 5 above were in conformance with the rules of the Michigan Board of Land Surveyors or by a Decree of a Court of Law; established, re-established, monumented, re-monumented, recovered, found as expressed below:

**NOTE: Not more than 4 corners, all in the same town and range, may be recorded on this certificate.**

**A. Description of original monument and accessories and/or subsequent restoration:**

C-13 (Sec. cor. common to Sections 31 & 32, T17N, R13W, on county line)

1838 John Mullett, D.S. (G.L.O)  
 #1 14" W. Pine N49°E 33 Links  
 #2 16" Hemlock N49°W 39 Links

1938 Bruce Elliott U.S.F.S. (Jr. Forester)  
 Cedar Stake for Monument  
 #3 Pine Post S81°E 0.04 Chains

In 1983 Clinton E. Cole, L.S. 17615, did not find any evidence of corner. He set the corner (1/2" rod) single proportionate distance between the S.W. corner of Sec. 31 and S. 1/4 corner Sec. 32, and took the following witnesses: #4 8" Maple S64°E 14.45', #5 6" Maple S12°W 43.22', #6 12" Oak N86°W 13.50'. He recorded Act 74 in Liber 02, Page 442.

**B. Description of corner evidence found and/or method applied in restoring or reestablishing corner:**

C-13 (Sec. cor. common to Sections 31 & 32, T17N, R13W, on county line)

I found Surveyor Coles' 1/2" rod and Elliott's pine post lying on ground. I was unable to find bottom of post. I re-measured the distance between the Southwest corner of Section 31 and South 1/4 corner Section 32 and support Surveyor Cole's proration. I accepted Surveyor Cole's 1/2" Rod as found. Condition of Accessories are: #1 Gone, #2 Gone, #3 Found in poor condition, #4 Found in good condition, #5 Found in good condition, #6 Found in good condition.

**C. Description of monument for corner and accessories established to perpetuate locating the position of the corner:**


C-13 (Sec. cor. common to Sections 31 & 32, T17N, R13W, on county line)

Replaced 1/2" Rod with 3/4" x 24" Re-rod with Lake County Brass Cap, and is accepted as a careful and faithful re-establishment of the position of the original corner.

- 10" R. Maple S64°E 14.45' (60d nail in SW side of tree) #4
- 8" R. Maple S12°W 43.22' (60d nail in NW side of tree) #5
- 14" W. Oak N86°W 13.34' (60d nail in SE side of tree) #6
- 8" R. Maple N25°E 25.03' (60d nail in SE side of tree)

Signed by Robert L. Wetherell  
 LS 24624

Date 12-13-93

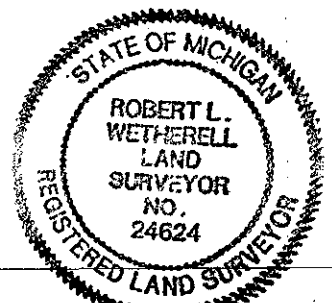

Surveyor's Michigan License No. \_\_\_\_\_

Approved by Peer Review Group December 6, 1993  
 Robert L. Wetherell, County Representative R L W