

**SURVEY & REMONUMENTATION**

JAN 1 2 1996

**COMMISSION**

**LAKE COUNTY REMONUMENTATION  
LAND CORNER RECORDATION CERTIFICATE**  
Filing Requirement of Act 74, Mich. P.A. 1970

LIBER 003 PAGE 0322

REGISTER OF DEEDS  
 SEP 5 3 06 PM '95  
 RECORDED  
 LAKE COUNTY, MI.

Register of Deeds Stamp & File Number

Corner in	Located In:	Corner Code
Public Land Survey	T 17N R 13W	E-8
Property Controlling in Section	S T R	
Miscellaneous Property in Sec.	S T R	

Lot No. \_\_\_\_\_ Recorded Plat \_\_\_\_\_  
Private Claims \_\_\_\_\_

	A	B	C	D	E	F	G	H	I	J	K	L	M
2	6	5	4	3	2	1							
3													
4	7	8	9	10	11	12							
5													
6	13	17	16	15	14	13							
7													
8	19	20	21	22	23	24							
9													
10	30	29	28	27	26	25							
11													
12	31	32	33	34	35	36							
13													

Robert L. Wetherell, in a field survey on August 10, 1995, hereby certify that under requirements of P.A. 74, Michigan P.A. of 1970, the corner points mentioned in lines 1 and 2 above were in conformance with regulations and rules therefore as required in the current manual of survey instructions of the United States Department of the Interior, Bureau of Land Management or by a decree of a Court of Law and/or that the corner points mentioned in lines 3, 4 and 5 above were in conformance with the rules of the Michigan Board of Land Surveyors or by a Decree of a Court of Law; established, re-established, monumented, re-monumented, recovered, found as expressed below:

**NOTE: Not more than 4 corners, all in the same town and range, may be recorded on this certificate.**

Description of original monument and accessories and/or subsequent restoration:

E-8 - 1/4 Corner common to Sections 20 & 21, T17N, R13W, Pleasant Plains Twp., Lake Co., Mi.

- |                                     |                                        |                                                                              |
|-------------------------------------|----------------------------------------|------------------------------------------------------------------------------|
| 1838 - John Hodgson, G.L.O.         | 1927 - George H. Johnson, Co. Surveyor | Undated - From old County Survey records                                     |
| #1 - 12" Pine N37°W 1.34 Links Iron | #3 - 12" B. Oak S32°30'E 23'           | #5 - Small concrete post 33 feet South of iron corner in centerline of road. |
| #2 - 4 Pine S28°E 15 Links          | #4 - 8" W. Oak N56°E 51'               |                                                                              |

(SEE OVER FOR CONTINUATION OF "A")

Description of corner evidence found and/or method applied in restoring or reestablishing corner:  
E-8 - 1/4 Corner common to Sections 20 & 21, T17N, R13W, Pleasant Plains Twp., Lake Co., Mi.

I found Griffin's 5" Square Concrete Monument in Monument box 2 feet more or Less South of centerline of East and West road. Condition of accessories are as follows: #1 Gone, #2 Gone, #3 Gone, #4 Gone, #5 Found in good condition, #6 Gone, #7 Found in good condition, #8 Found in good condition, #9 Found rotted off.


Description of monument for corner and accessories established to perpetuate locating the position of the corner:

E-8 - 1/4 Corner common to Sections 20 & 21, T17N, R13W, Pleasant Plains Twp., Lake Co., Mi.

I placed a 3/4" re-bar with Lake County Brass Cap directly over the center of the 5" Square Monument, and is accepted as a careful and faithful re-establishment of the position of the original corner.

- 18" Tw. B. Oak N65°W 103.67' (60d spike in S. side)
- 15" B. Oak N20°E 106.33' (60d spike in W. side)
- 7" B. Oak S50°E 63.88' (60d spike in N.E. side)
- 23" B. Oak South 79.90' (Dock Spike in W. side)
- 2" x 3" Concrete Monument South 33.52'

Surveyed by Robert L. Wetherell Date August 29, 1995  
Surveyor's Michigan License No. 24624

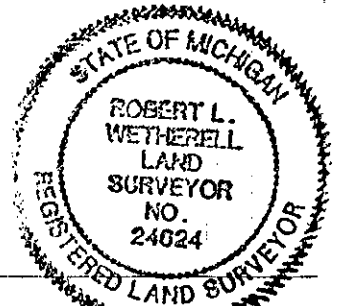

RATIFIED BY THE LAKE CO. PEER REVIEW GROUP  
IN ACCORDANCE WITH P.A. 345  
CHAMPLAIN

CONTINUATION OF "A" - DESCRIPTION OF ORIGINAL MONUMENT AND ACCESSORIES AND/OR SUBSEQUENT RESTORATION.

1952 - George Blass, LS 5489

Found iron rod and old wood stake  
under blacktop road. Raised  
to surface with 1/2" rod.

#6 - 6" J. Pine N30°E 117.55'

#7 - 12" B. Oak S4°E 79.65'

#8 - 8" Tw. B. Oak N67°W 103.35'

1970 - Robert A. Griffin, LS 13584

Found 1/2" x 15" Rod directly over  
a 3" x 1" x 27" Long Cast Iron Lever.

Replaced with a 5" Square Concrete Monument

#9 - 4" x 7" Post South 33.06'

#7 - 17" B. Oak S4°E 80.05'

8 - 12" Tw. B. Oak N67°W 103.65'

LIBER003 PAGE0323

SURVEY &  
REMONUMENTATION

JAN 12 1996

COMMISSION