

REMONUMENTATION
 FEB 18 1994
 COMMISSION

RECORDED
 LAKE COUNTY, MI.
 LIBER 003 PAGE 0206
 DEC 13 3 42 PM '93

**LAKE COUNTY REMONUMENTATION
 LAND CORNER RECORDATION CERTIFICATE
 Filing Requirement of Act 74, Mich. P.A. 1970**

Lucinda H. Reckow
 REGISTER OF DEEDS

For corners in

Lake (County)	Located In:	Corner Code #
1. Public Land Survey	T 17 N R 13 W	E-13
	T _____ R _____	_____
	T _____ R _____	_____
	T _____ R _____	_____
2. Property Controlling in Section	S _____ T _____ R _____	_____
	S _____ T _____ R _____	_____
3. Miscellaneous Property in Sec.	S _____ T _____ R _____	_____
	S _____ T _____ R _____	_____

Register of Deeds Stamp & File Number

4. Lot No. _____, Recorded Plat _____
 5. Private Claims _____

	A	B	C	D	E	F	G	H	I	J	K	L	M
2	6		5		4		3		2		1		
3													
4	7		8		9		10		11		12		
5													
6	18		17		16		15		14		13		
7													
8	19		20		21		22		23		24		
9													
10	30		29		28		27		26		25		
11													
12	31		32		33		34		35		36		
13													

I, Robert L. Wetherell, in a field survey on November 4, 1993, do hereby certify that under requirements of P.A. 74, Michigan P.A. of 1970, the corner points mentioned in lines 1 and 2 above were in conformance with regulations and rules therefore as required in the current manual of survey instructions of the United States Department of the Interior, Bureau of Land Management or by a decree of a Court of Law and/or that the corner points mentioned in lines 3, 4 and 5 above were in conformance with the rules of the Michigan Board of Land Surveyors or by a Decree of a Court of Law; established, re-established, monumented, re-monumented, recovered, found as expressed below:

NOTE: Not more than 4 corners, all in the same town and range, may be recorded on this certificate.

A. Description of original monument and accessories and/or subsequent restoration:
 E-13 (Section corner common to Sections 32 & 33, T17N, R13W, on County Line)

1838 John Mullet, D.S. G.L.O.
 #1 14" B. Ash N34°E 42 Links
 #2 12" B. Ash N72°W 47 Links

1907 George West, Surveyor
 #4 24" W. Pine Stump N49°E 33 Links

1938 Brue Elliott USFS (Jr. Forester)
 Wood stake for monument and set
 #3 Pine Post N75°E 0.12 Chains

1983 Clinton E. Cole, L.S. 17615
 Found Elliott's post and set corner (1/2" rod) using Elliott's bearing and distance and took the following witnesses:
 #5 13" Maple S 8°E 23.08'
 #6 11" Maple S20°W 35.70'
 #7 14" Maple N65°W 26.28'
 #8 10" Maple N20°E 26.67'

B. Description of corner evidence found and/or method applied in restoring or reestablishing corner:

E-13 (Section corner common to Sections 32 & 33, T17N, R13W, on County Line)

I found 1/2" re-rod set by Clinton Cole. I also found old Pine Post by Elliott leaning against tree 4.5' East of iron. Condition of accessories are: #1 Gone, #2 Gone, #3 Found against tree, #4 gone, #5 Found in good condition, #6 Found in good condition, #7 Found in good condition, #8 Found in good condition.

C. Description of monument for corner and accessories established to perpetuate locating the position of the corner:

E-13 (Section corner common to Sections 32 & 33, T17N, R13W, on County Line)


Replaced 1/2" re-rod with 3/4" x 24" re-rod with Lake County Brass Cap, and is accepted as a careful and faithful re-establishment of the position of the original corner.

- 13" S. Maple S11°E 23.16' (60d nail in SE side of tree) (#5)
- 11" S. Maple S20°W 35.70' (60d nail in NW side of tree) (#6)
- 15" S. Maple N76°W 26.27' (60d nail in SW side of tree) (#7)
- 8" S. Maple N17°E 26.63' (60d nail in NW side of tree) (#8)

Signed by Robert L. Wetherell
 LS 24624

Date 12-13-93

Surveyor's Michigan License No. _____

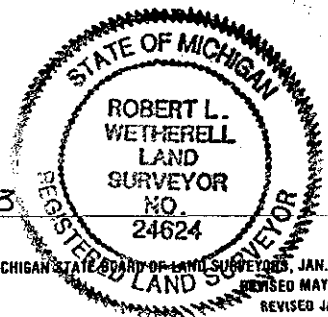

Approved by Peer Review Group December 6, 1993
 Robert L. Wetherell, County Representative *R.L.W.*