

**SURVEY & REMONUMENTATION**

DEC 14 1999

SECTION

**LAND CORNER RECORDATION CERTIFICATE**

FILING REQUIREMENT OF ACT 74, Mich. P.A. 1970

For corners in  
Lake

Located in: Corner Code#

1. Public Land Survey	T 17 N	R 13 W	G-2
	T	R	
	T	R	
	T	R	
2. Property Controlling s in Section	T	R	
	S	T	R
3. Miscellaneous Property in Sec.	S	T	R
	S	T	R
4. Lot No. _____ Recorded Plat			
5. Private Claims			

RECORDED  
LAKE COUNTY, MI  
LIBER 004 PAGE 0224

DEC 9 9 57 AM '99

*Shelley Myers*  
REGISTER OF DEEDS

Register of Deeds Stamp & File Number

I, Robert L. Wetherell, in a field survey on September 28, 1999, do hereby certify that under requirements of P.A. 74, Michigan P.A. of 1970, the corner points mentioned in lines 1 and 2 above were in conformance with regulations and rules therefore as required in the current manual of survey instructions of the United States Department of the Interior, Bureau of Land Management or by decree of a Court of Law and/or that the corner points mentioned in lines 3, 4, and 5 above were in conformance with the rules of the Michigan Board of Land Surveyors or by a Decree of a Court of Law; established, re-established, monumented, re-monumented, recovered, found as expressed below:

	A	B	C	D	E	F	G	H	I	J	K	L	M
1													
2	6	5	4	3	2	1							
3													
4	7	8	9	10	11	12							
5													
6	18	17	16	15	14	13							
7													
8	19	20	21	22	23	24							
9													
10	30	29	28	27	26	25							
11													
12	31	32	33	34	35	36							
13													

G-2 - 1/4 Corner common to Sections 3 & 4, T17N, R13W, Lake Co., MI.

**A. Description of original monument and accessories and/or subsequent restoration:**

1838 - J. Hodgson, G.L.O.

- #1 - 8" Pine N89°E 7 Links
- #2 - 4" Pine S80°W 25 Links

1922 - G. H. Johnson, Co. Sur.

- 3/4" Bolt 16" Long
- #3 - 16" B. Oak N14°W 88'

Undated - G.H. Johnson, Co. Sur.

- #4 - N.E. cor. house cement foundation S35°W 109'
- #3 - 14" B. Oak N14°W 88'

1954 - G. Blass, LS 5489

- Set R.R. Spike
- #5 - 24" B. Oak N22°W 78.23'
- #6 - P. Pole S29°E 40.87'
- #7 - Conc. Post (N.E. Cor. Porch) S42°W 102.36'

1958 - G. Blass, LS 5489

Developed plat of "Forest Field"  
This corner is the N.W. cor. of Plat.  
#8 - Set. Conc. Monument 33' East and 33' South.

1996 - R.L. Wetherell, LS 24624

Survey recorded Liber 04, Pg. 113  
#9 - P. Pole S23°E 43.68' (60d spike N.E. side)  
#10 - 14" Cherry N62°E 52.33' (60d spike N.W. side)  
#11 - 14" Tw.B. Oak N34°E 98.96' (60d spike S.E. side)  
#12 - 16" Spruce S24°W 101.87' (60d spike N.W. side)

**B. Description of corner evidence found and/or method applied in restoring of reestablishing corner:**

I found Blass' railroad spike 4' North of centerline of East and West road and in centerline of roads North and South. I also found an old 1-1/2" pipe S56°E 3.0 feet from the railroad spike. I accepted the railroad spike as the correct corner, as it best fit accessory #4 by G. H. Johnson and I did not know the origin of the 1 1/2" Pipe. I removed the pipe.


Condition of the accessories are as follows: #1 Gone, #2 Gone, #3 Gone, #4 Found in good condition, #5 Found in good condition, #6 New Pole, #7 Found in good condition, #8 Found in good condition, #9 Found in good condition, #10, Found in good condition, #11 Found in good condition, #12 Found in good condition.

**C. Description of monument for corner and accessories established to perpetuate locating the position of the corner:**

I replaced the railroad spike with a 3/4" x 24" re-bar with Lake County Remon Cap, and is accepted as a careful and faithful reestablishment of the position of the original corner.

- Northeast corner House Foundation S42°W 108.45' - #4
- P. Pole S23°E 43.68' (60d spike in N.E. side) #9
- 14" Tw. Cherry N62°E 52.33' (60d spike in N.W. side) #10
- 14" Tw. B. Oak N34°E 98.95' (60d spike in S.E. side) #11
- 16" Spruce S24°W 101.87' (60d spike in N.W. side) #12

RATIFIED BY THE LAKE CO. PEER REVIEW GROUP  
IN ACCORDANCE WITH P.A. 345  
CHAIRMAN *P.L.W.*  
DATE 10-19-99

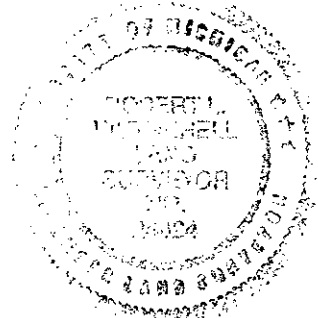

Signed by Robert L. Wetherell

Date 10-22-99

Surveyor's Michigan License No. 24624