

JAN 25 2001

SECTION

LAND CORNER RECORDATION CERTIFICATE

FILING REQUIREMENT OF ACT 74, Mich. P.A. 1970

For corners in Lake _____	Located in:	Corner Code#
1. Public Land Survey	T 17 N R 13 W G-4	
	T R	
	T R	
	T R	
2. Property Controlling in Section	S T R	
	S T R	
3. Miscellaneous Property in Sec.	S T R	
	S T R	
4. Lot No. _____ Recorded Plat _____		
5. Private Claims _____		

RECORDED
LAKE COUNTY, MI
LIBER 004 PAGE 0267

DEC 8 11 17 AM '00

Shelley Myers

REGISTER OF DEEDS

Register of Deeds Stamp & File Number

	A	B	C	D	E	F	G	H	I	J	K	L	M
1													
2	6	5	4	3	2	1							
3													
4	7	8	9	10	11	12							
5													
6	18	17	16	15	14	13							
7													
8	19	20	21	22	23	24							
9													
10	30	29	28	27	26	25							
11													
12	31	32	33	34	35	36							
13													

I, Robert L. Wetherell, in a field survey on November 7, 2000, do hereby certify that under requirements of P.A. 74, Michigan P.A. of 1970, the corner points mentioned in lines 1 and 2 above were in conformance with regulations and rules therefore as required in the current manual of survey instructions of the United States Department of the Interior, Bureau of Land Management or by decree of a Court of Law and/or that the corner points mentioned in lines 3, 4, and 5 above were in conformance with the rules of the Michigan Board of Land Surveyors or by a Decree Of a Court of Law; established, re-established, monumented, re-monumented, recovered, found as expressed below:

G-4 - 1/4 Corner common to Sections 9 & 10, T17N, R13W

A. Description of original monument and accessories and/or subsequent restoration:

1838 - J. Hodgson, G.L.O.
#1 - 4" Pine N40°W 20 Links
#2 - 4" Pine S43°E 25 Links

1975 - C. Roser, LS 12028
Found Greg Shadko monument set in 1962.
#6 - Distance South = 2636.73'

1993 - R.L. Wetherell, LS 24624

Found Shadko monument lying on shoulder of road. Reset using monumentation on the West line of Section 10.

1951 - G. Blass, LS 5489
Found 3/4" Iron Pipe
#3 - 10" J. Pine Due West 61.51'
#4 - 12" B. Oak N23°W 57.0'
#5 - 10" J. Pine N43°E 16.00'
#6 - Distance South = 2636.5'

1978 - R.L. Wetherell, LS 24624
Unrecorded survey.
#7 - 1/2" Rod 33 feet West.

#8 - 16" B. Oak N24°E 54.96'
#9 - 6" B. Oak S74°E 43.04'
#10 - 8" W. Oak N56°W 64.88'
#11 - 9" W. Pine S71°W 73.72'

B. Description of corner evidence found and/or method applied in restoring of reestablishing corner:

I found a 4" pipe with brass cap marked "G. Shadko, 1962". Corner is on the East edge of a North and South dirt road.


Condition of the accessories are as follows: #1 Gone, #2 Gone, #3 Found remains, #4 Gone, #5 Found in good condition, #6 Measured 2636.74', #7 Found in good condition, #8 Found in good condition, #9 Found in good condition, #10 Found in good condition, #11 Found in good condition.

C. Description of monument for corner and accessories established to perpetuate locating the position of the corner:

I accepted the 4" pipe with brass cap as a substantial marker for the corner, and is accepted as a careful and faithful reestablishment of the position of the original corner.

- 16" B. Oak N25°E 54.91' (60d spike W. side) #8
- 11" W. Pine S72°W 73.72' (dock spike in N. side) #11
- 7" W. Pine S34°W 79.84' (60d spike E. side)
- 13" B. Oak N47°W 91.65' (60d spike S.W. side)
- 9" W. Oak N18°W 129.43' (60d spike W. side)
- 6" B. Oak S74°E 43.04' (60d spike N. side) #9
- 8" W. Oak N56°W 64.88' (60d spike S.W. side) #10

VALIDATED BY THE LAKE CO. PEER REVIEW GROUP
IN ACCORDANCE WITH P.A. 345
CHRISTIAN R JW
DATE 12-5-2000

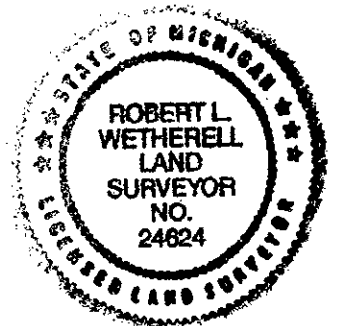

Signed by Robert L. Wetherell
Surveyor's Michigan License No. 24624

Date December 6, 2000