

FEB 18 1994

LAKE COUNTY REMONUMENTATION

RECORDED  
LAKE COUNTY, MI.  
NUMBER 003 PAGE 0209

LAND CORNER RECORDATION CERTIFICATE  
Filing Requirement of Act 74, Mich. P.A. 1970

DEC 13 3 42 PM '93

For corners in

Lake (County)	Located In:	Corner Code ##
1. Public Land Survey	T <u>17</u> N R <u>13</u> W	H-13
	T _____ R _____	_____
	T _____ R _____	_____
	T _____ R _____	_____
2. Property Controlling in Section	S _____ T _____ R _____	_____
	S _____ T _____ R _____	_____
3. Miscellaneous Property in Sec.	S _____ T _____ R _____	_____
	S _____ T _____ R _____	_____

*Richard H. Richard*  
REGISTER OF DEEDS

Register of Deeds Stamp & File Number

- 4. Lot No. \_\_\_\_\_, Recorded Plat \_\_\_\_\_
- 5. Private Claims \_\_\_\_\_

	A	B	C	D	E	F	G	H	I	J	K	L	M
2	6	5	4	3	2	1							
3													
4	7	8	9	10	11	12							
5													
6	18	17	16	15	14	13							
7													
8	19	20	21	22	23	24							
9													
10	30	29	28	27	26	25							
11													
12	31	32	33	34	35	36							
13													

I, Robert L. Wetherell, in a field survey on October 28, 1993, do hereby certify that under requirements of P.A. 74, Michigan P.A. of 1970, the corner points mentioned in lines 1 and 2 above were in conformance with regulations and rules therefore as required in the current manual of survey instructions of the United States Department of the Interior, Bureau of Land Management or by a decree of a Court of Law and/or that the corner points mentioned in lines 3, 4 and 5 above were in conformance with the rules of the Michigan Board of Land Surveyors or by a Decree of a Court of Law; established, re-established, monumented, re-monumented, recovered, found as expressed below:

NOTE: Not more than 4 corners, all in the same town and range, may be recorded on this certificate.

A. Description of original monument and accessories and/or subsequent restoration:

H-13 (1/4 Corner Section 34, T17N, R13W, on County Line)

1838 John Mullett, D.S. G.L.O.  
 #1 8" W. Pine N39°W 1.66 Links  
 #2 8" W. Pine N56°E 18 Links  
1907 G.N. West, Surveyor  
 (No monument given)  
 #3 10" B. Oak N52°W 187-1/2 Links

1927 M.S.H.D.  
 Monument - Ford Axle  
 #4 Tw. Oak N45°E 40.5'  
 #5 8" Oak S67°W 45.0'  
 #6 6" Oak N71°W 46.8'

Undated G.H. Johnson, County Surveyor  
 Monument - Iron Pipe  
 # 7 8" B. Oak N21°15"E 108'  
 # 8 8" B. Oak S70°30'E 79.5'  
 # 9 7" B. Oak S87°30'W 43'  
 #10 6" B. Oak N62°30'W 58.2'

(SEE REVERSE SIDE OF LAND RECORDATION CERTIFICATE FOR CONTINUATION OF "A")

B. Description of corner evidence found and/or method applied in restoring or reestablishing corner:

H-13 (1/4 Corner Section 34, T17N, R13W, on County Line)

I found Griffin's concrete monument in monument box. Condition of accessories are: #1 Gone, #2 Gone, #3 Gone, #4 Gone, #5 Found in good condition, #6 Gone, #7 Gone, #8 Gone, #9 Found in good condition, #10 Gone, #11 Gone, #12 Found in good condition, #13 Found in good condition, #14 Gone, #15 Gone, #16 Cut, #17 Gone.

C. Description of monument for corner and accessories established to perpetuate locating the position of the corner:


H-13 (1/4 Corner Section 34, T17N, R13W, on County Line)

Found concrete monument with brass cap in monument box. Accepted as a substantial marker for the 1/4 corner and is accepted as a careful and faithful re-establishment of the position of the original corner.

13" B. Oak N64°W 237.90' (60d nail in SW side of tree)  
 14" W. Oak N39°E 231.92' (60d nail in NW side of tree)  
 Horizontal controll monument with brass cap S55°E 53.65'  
 18" B. Oak S70°W 42.82' (60d nail in North side of tree)

Signed by Robert L. Wetherell  
 LS 24624  
 Surveyor's Michigan License No. \_\_\_\_\_  
 Approved by Peer Review Group December 6, 1993 R.L.W.  
 Robert L. Wetherell, County Representative

Date 12-13-93

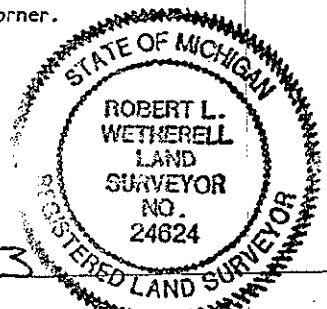

LAND CORNER RECORDATION CERTIFICATE "A" CONTINUED

1955 - G. Blass, L.S. 5489

Found Iron Pipe

#11 T. Pole N65°E 74.20'

#12 NW Corner House S65°E 102.85'

#13 14" B. Oak S73°W 42.82 (Johnson's OBT #9)

#14 12" B. Oak N62°30'W 58.03' (Johnson' OBT #10)

1972 - Robert Griffin, L.S. 13584

Found 1" Pipe and replaced with  
5" x 36" Brass Cap Concrete Monument

#15 T. Pole N65°E 74.28' (Blass OBT #11)

#16 T. Pole N60°W 69.05

#17 Pine Post N68°E 82.12'

Recorded Act 74 in Liber 02, Page 97.