

JAN 12 1996

COMMISSION

LAND CORNER RECORDATION CERTIFICATE

Filing Requirement of Act 74, Mich. P.A. 1970

LIBER 003 PAGE 0335

For corners in

Lake (County)	Located In:		Corner Code ##
	17N	13W	
1. Public Land Survey	T	R	I-3
	T	R	
	T	R	
	T	R	
2. Property Controlling in Section	S	T	R
	S	T	R
3. Miscellaneous Property in Sec.	S	T	R
	S	T	R


REGISTER OF DEEDS
 Register of Deeds Stamp & File Number
 RECORDED
 LAKE COUNTY, MI.
 OCT 30 2 45 PM '95

- 4. Lot No. _____, Recorded Plat _____
- 5. Private Claims _____

Robert L. Wetherell, in a field survey on October 12, 1995

I, _____, do hereby certify that under requirements of P.A. 74, Michigan P.A. of 1970, the corner points mentioned in lines 1 and 2 above were in conformance with regulations and rules therefore as required in the current manual of survey instructions of the United States Department of the Interior, Bureau of Land Management or by a decree of a Court of Law and/or that the corner points mentioned in lines 3, 4 and 5 above were in conformance with the rules of the Michigan Board of Land Surveyors or by a Decree of a Court of Law; established, re-established, monumented, re-monumented, recovered, found as expressed below:

NOTE: Not more than 4 corners, all in the same town and range, may be recorded on this certificate.

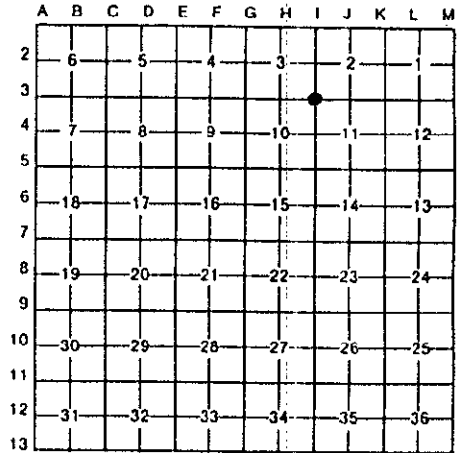

A. Description of original monument and accessories and/or subsequent restoration.

- 1-3 - Section corner common to Sections 2, 3, 10 and 11, T17N, R13W, Lake Co., Mi.
- 1838 - John Hodgson, G.L.O.
- #1 - 24" Pine S27°E 32 Links
- #2 - 24" Pine N33°W 6 Links
- 1928 - George Johnson, Co. Surveyor
- #5 - 16" B. Oak S70°45'E 74.5'
- #6 - 12" B. Oak N48°30'E 81.9'
- 1951 - George Blass, LS 5489
- Found 1" Iron Bar
- #7 - 8" W. Oak N54°W 53.7'
- #8 - 20" B. Oak N49°E 31.15'
- George Johnson, Co. Surveyor (Prior to 1928)
- #3 - 16" B. Oak S48°E 49.0'
- #4 - 14" B. Oak S24°W 59.0'

B. Description of corner evidence found and/or method applied in restoring or reestablishing corner:

I-3 - Section corner common to Sections 2, 3, 10 and 11, T17N, R13W, Lake Co., Mi.

I found a 1-1/4" x 21" pointed rod directly over a 5/8" x 18" iron rod with remains of a wood stake. Along side of the irons I found a triangular shaped stone with 10" sides and 18" in length with a flat top. Condition of accessories are as follows: #1 Gone, #2 Gone, #3 Found in good condition, #4 Gone, #5 Found decayed stump, #6 Gone, #7 Found in good condition, #8 Gone. Corner is in road intersection.

C. Description of monument for corner and accessories established to perpetuate locating the position of the corner:

I-3 - Section corner common to Sections 2, 3, 10 and 11, T17N, R13W, Lake Co., Mi.


I replaced the iron rods found with a 3/4" x 24" re-bar with Lake County Brass Cap, and is accepted as a careful and faithful re-establishment of the position of the original corner.

- 28" B. Oak S42°E 49.50' (60d spike in S.W. side) (#3)
- 12" W. Oak N48°W 53.81' (60d spike in S.W. side) (#7)
- 10" Forked W. Oak S60°W 51.15' (60d spike in N.W. side)
- Center of Pitcher Pump N78°E 113.56'

Signed by Robert L. Wetherell
24624

Date 10-26-95

Surveyor's Michigan License No. _____

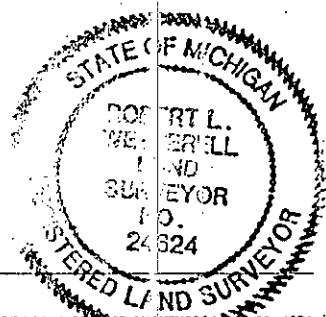

RATIFIED BY THE LAKE CO. PEER REVIEW GROUP
IN ACCORDANCE WITH P.A. 345
CHAIRMAN R.W.
DATE 10-23-95