

FEB 10 1993
 COMMISSION

LAKE COUNTY REMONUMENTATION
 LAND CORNER RECORDATION CERTIFICATE
 Filing Requirement of Act 74, Mich. P.A. 1970

RECORDED
 LAKE COUNTY, MI.
 LIBER 003 PAGE 0210
 Dec 13 3 43 PM '93

Secordia H. Dechaus
 REGISTER OF DEEDS

For corners in

Lake (County)	Located In:	Corner Code #
1. Public Land Survey	T <u>17</u> N R <u>13</u> W	I-13
	T _____ R _____	_____
	T _____ R _____	_____
	T _____ R _____	_____
2. Property Controlling in Section	S _____ T _____ R _____	_____
	S _____ T _____ R _____	_____
3. Miscellaneous Property in Sec.	S _____ T _____ R _____	_____
	S _____ T _____ R _____	_____

Register of Deeds Stamp & File Number

4. Lot No. _____, Recorded Plat _____
 5. Private Claims _____

	A	B	C	D	E	F	G	H	I	J	K	L	M
2	6		5		4		3		2		1		
3													
4	7		8		9		10		11		12		
5													
6	18		17		16		15		14		13		
7													
8	19		20		21		22		23		24		
9													
10	30		29		28		27		26		25		
11													
12	31		32		33		34		35		36		
13													

I, Robert L. Wetherell, in a field survey on November 4, 19 93, do hereby certify that under requirements of P.A. 74, Michigan P.A. of 1970, the corner points mentioned in lines 1 and 2 above were in conformance with regulations and rules therefore as required in the current manual of survey instructions of the United States Department of the Interior, Bureau of Land Management or by a decree of a Court of Law and/or that the corner points mentioned in lines 3, 4 and 5 above were in conformance with the rules of the Michigan Board of Land Surveyors or by a Decree of a Court of Law; established, re-established, monumented, re-monumented, recovered, found as expressed below:

NOTE: Not more than 4 corners, all in the same town and range, may be recorded on this certificate.

A. Description of original monument and accessories and/or subsequent restoration:

I-13 - (Section corner common to Sections 34 & 35, T17N, R13W, on County line)

- | | | |
|--|-------------------------------------|--|
| <u>1838 - John Mullett, D.S., G.L.O.</u> | <u>1907 - George West, Surveyor</u> | <u>1936 - W.H. Welton, USFS Forester</u> |
| #1 8" W. Pine N33°E 2.66 Links | Set 1/2" Iron for Monument | Iron Rod for Monument |
| #2 8" W. Pine N28°W 2.90 Links | #3 8" B. Oak N34°E 170-1/4 Links | #5 12" W. Oak N10°W .555 Chains |
| | #4 6" W. Oak N12°W 55-1/2 Links | #6 14" W. Oak _____ 1.075 Chains |

(SEE OVER FOR CONTINUATION OF "A" - LAND CORNER RECORDATION CERTIFICATE)

B. Description of corner evidence found and/or method applied in restoring or reestablishing corner:

I-13 - (Section corner common to Sections 34 & 35, T17N, R13W, on County line)

I found 1/2" pipe by George West, condition of accessories are: #1 Gone, #2 Gone, #3 Gone, #4 Gone, #5 Gone, #6 Gone, #7 Gone, #8 Found in good condition, #9 Found in good condition, #10 Found in good condition


C. Description of monument for corner and accessories established to perpetuate locating the position of the corner:

I-13 - (Section corner common to Sections 34 & 35, T17N, R13W, on County line)

I replaced 1/2" Iron Pipe with a 3/4" x 24" Re-rod with Lake County Brass Cap and is accepted as a careful and faithful re-establishment of the position of the original corner.

- 12" B. Oak N21°W 99.50' (60d nail in NE side of tree)
- 12" W. Oak S44°E 62.64' 16p spike and washer in NE side of tree) (#10)
- 12" B. Oak S28°W 61.08' (16p spike and washer in SE side of tree) (#11)
- Concrete well pit, inside SW corner N29°E 127.15' (#9)

Signed by Robert L. Wetherell Date 12-13-93
 Surveyor's Michigan License No. LS 24624

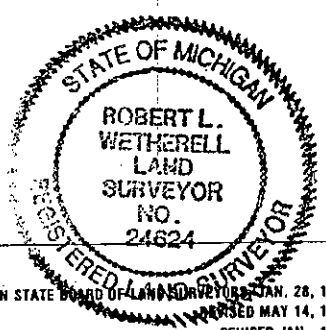

Approved by Peer Review Group December 6, 1993
 Robert L. Wetherell, County Representative

CONTINUATION OF "A" - LAND CORNER RECORDATION CERTIFICATE

1956 - George Blass, LS 5489

Found 1/2" Iron Pipe and witnesses
of G.N. West

7 16" W. oak N12°W 36.50' (West's #4)

8 18" B. oak N60°E 72.60'

9 Concrete well pit (SW corner, inside)
N29°30'E 127.15'

#10 8" W. oak S44°E 62.64'

#11 8" B. oak S28°W 61.08'