

MAY 1 3 1997

CONF.

LIBER 003 PAGE 0380

LAND CORNER RECORDATION CERTIFICATE
Filing Requirement of Act 74, Mich. P.A. 1970

For corners in

Lake (County)	Located In:		Corner Code #
	17N	13W	
1. Public Land Survey	T	R	K-7
	T	R	
	T	R	
	T	R	
2. Property Controlling in Section	S	T	R
	S	T	
3. Miscellaneous Property in Sec.	S	T	R
	S	T	

REGISTERED
 LAKE COUNTY, MI.
 NOV 14 11 22 AM '96
 REGISTER OF DEEDS

Register of Deeds Stamp & File Number

- 4. Lot No. _____, Recorded Plat _____
- 5. Private Claims _____

A	B	C	D	E	F	G	H	I	J	K	L	M
2	6	5	4	3	2	1						
3												
4	7	8	9	10	11	12						
5												
6	18	17	16	15	14	13						
7												
8	19	20	21	22	23	24						
9												
10	30	29	28	27	26	25						
11												
12	31	32	33	34	35	36						
13												

I, Robert L. Wetherell, in a field survey on September 19, 1996, do hereby certify that under requirements of P.A. 74, Michigan P.A. of 1970, the corner points mentioned in lines 1 and 2 above were in conformance with regulations and rules therefore as required in the current manual of survey instructions of the United States Department of the Interior, Bureau of Land Management or by a decree of a Court of Law and/or that the corner points mentioned in lines 3, 4 and 5 above were in conformance with the rules of the Michigan Board of Land Surveyors or by a Decree of a Court of Law; established, re-established, monumented, re-monumented, recovered, found as expressed below:

NOTE: Not more than 4 corners, all in the same town and range, may be recorded on this certificate.

A. Description of original monument and accessories and/or subsequent restoration:

K-7 - Section corner common to Sections 13, 14, 23 & 24, T17N, R13W, Lake Co., Mi.


- | | | |
|--|--|--|
| <u>1838 - John Hodgson, G.L.O.</u> | <u>Undated - County Survey Records</u> | <u>1958 - George Blass, LS 5489</u> |
| <u>#1 - 12" Pine N48°W 18 Links</u> | <u>#5 - 18" B. Oak S62°W 11'</u> | <u>Found 1/2" Triangular rod from</u> |
| <u>#2 - 14" Pine S8°W 30 Links</u> | <u>#6 - 12" J. Pine N22°E 84'</u> | <u>G. Johnson witnesses.</u> |
| <u>1907 - George West, Deputy Surveyor</u> | <u>1930 - G. Johnson, Co. Surveyor</u> | <u>#7 - S.E. cor. House N1°W 25.73'</u> |
| <u>Found stumps of original bearing</u> | <u>#3 - 10" W. Oak N42°30'E 18'</u> | <u>#8 - S.W. cor. House N51°W 36.25'</u> |
| <u>trees, set oak stake.</u> | <u>#4 - 12" B. Oak Stump S.W. 6'</u> | <u>1972 - Clinton E. Cole, LS 17615</u> |
| <u>#3 - 12" W. Oak N42°E 25 Links</u> | | <u>1-1/4" Pipe</u> |
| <u>#4 - 12" B. Oak S75°W 10 Links</u> | | <u>Same witnesses as Blass in 1958.</u> |

B. Description of corner evidence found and/or method applied in restoring or reestablishing corner:

K-7 - Section corner common to Sections 13, 14, 23 & 24, T17N, R13W, Lake Co., Mi.

I found a 1-1/2" x 48" Pipe with Triangular Iron inside of it. I recovered accessories No. 3, No. 7 and No. 8, all other accessories were gone.

RATIFIED BY THE LAKE CO. PEER REVIEW GROUP
 IN ACCORDANCE WITH P.A. 345
 CHAIRMAN R.S.W.
 DATE 11-12-96

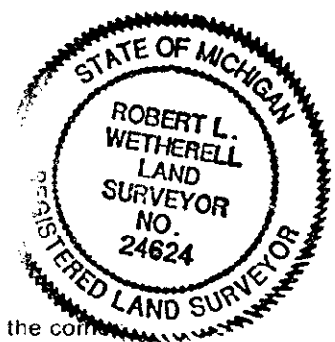

C. Description of monument for corner and accessories established to perpetuate locating the position of the corner:

K-7 - Section corner common to Sections 13, 14, 23 & 24, T17N, R13W, Lake Co., Mi.

I replaced Pipe and Triangular Iron with a 3/4" x 24" re-bar with Lake County Brass Cap, and is accepted as a careful and faithful perpetuation of the position of the original corner.

- S.E. Corner of Cabin N4°E 25.73' - #7
- S.W. Corner of Cabin N46°W 36.25' - #8
- 18" W. Oak N46°E 17.38' (60d spike in N.W. side) O.B.T. #3
- 8" W. Pine S54°E 50.74' (60d spike in N.E. side)
- 11" W. Oak S30°W 49.33' (60d spike in S.E. side)

Signed by Robert L. Wetherell Date 11-13-1996
 Surveyor's Michigan License No. 24624