

MEMORIAL

MAY 1 1997

LIBER 003 PAGE 0382

LAND CORNER RECORDATION CERTIFICATE
Filing Requirement of Act 74, Mich. P.A. 1970

For corners in

Table with columns: Lake (County), Located In: (17N, 13W), Corner Code # (K-9). Rows include Public Land Survey, Property Controlling in Section, and Miscellaneous Property in Sec.

RECORDED
LAKE COUNTY, MI.
Nov 14 11 23 AM '96
REGISTER OF DEEDS

Register of Deeds Stamp & File Number

4. Lot No. , Recorded Plat
5. Private Claims

Grid table with columns A-M and rows 2-13. A black dot is present in the cell corresponding to column J and row 9.

Robert L. Wetherell September 19, 96

I, in a field survey on 19 do hereby certify that under requirements of P.A. 74, Michigan P.A. of 1970, the corner points mentioned in lines 1 and 2 above were in conformance with regulations and rules therefore as required in the current manual of survey instructions of the United States Department of the Interior, Bureau of Land Management or by a decree of a Court of Law and/or that the corner points mentioned in lines 3, 4 and 5 above were in conformance with the rules of the Michigan Board of Land Surveyors or by a Decree of a Court of Law; established, re-established, monumented, re-monumented, recovered, found as expressed below:

NOTE: Not more than 4 corners, all in the same town and range, may be recorded on this certificate.

A. Description of original monument and accessories and/or subsequent restoration:

K-9 - Section corner common to Sections 23, 24, 25 & 26, T17N, R13W, Lake Co., Mi.

- 1838 - John Hodgson, G.L.O. 1923 - George Johnson, County Surveyor
#1 - 8" Pine S61°W 33 Links #3 - 20" B. Oak 5°30'W 16'
#2 - 6" Pine N46°E 19 Links #4 - 7" B. Oak N80°W 55'


- 1973 - Clinton E. Cole, LS 17615
L.C.R.C. - Liber 02, Page 176
Found cedar post and O.B.T. from U.S.F.S. Notes (C.C.C.) and set a Concrete Monument
#5 - 10" J. Pine S60°E 30.69'
#6 - 6" B. Oak S82°W 15.92'
#7 - 10" B. Oak N12°E 16.24'

B. Description of corner evidence found and/or method applied in restoring or reestablishing corner:

K-9 - Section corner common to Sections 23, 24, 25 & 26, T17N, R13W, Lake Co., Mi.

I found 4" Brass Capped Monument (marked Blass Surveys). I recovered the remains of both Johnson's accessories No. 3 and No. 4 and accessories No. 5, No. 6 and No. 7. Accessories No. 1 & No. 2 were not recovered.

RATIFIED BY THE LAKE CO. PEER REVIEW GROUP
IN ACCORDANCE WITH P.A. 345
CHAIRMAN R.L.W.
DATE 11-12-96

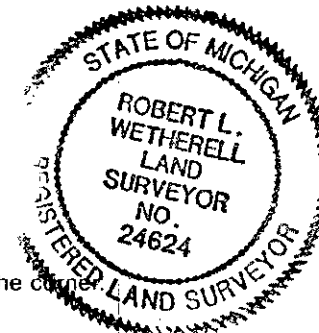

C. Description of monument for corner and accessories established to perpetuate locating the position of the corner:

K-9 - Section corner common to Sections 23, 24, 25 & 26, T17N, R13W, Lake Co., Mi.

I accepted the 4" Concrete Monument to be the corner, and is accepted as a careful and faithful re-establishment of the position of the original corners.

- 9" J. Pine S44°E 30.68' (60d spike in N.E. side above Blass washer) #5
12" B. Oak N18°E 16.14' (60d spike in below Blass washer) #7
8" B. Oak S85°W 15.98' (60d spike in S. side)
6" R. Pine N54°W 30.35' (60d spike in S.W. side)
6" R. Pine N71°E 60.94' (60d spike in N. side)

Signed by Robert L. Wetherell 24624

Date 11-13-96

Surveyor's Michigan License No.