

RECORDED
LAKE COUNTY, MI.
LIBER 003 PAGE 0213
Dec 13 3 43 PM '93

LAKE COUNTY REMONUMENTATION
LAND CORNER RECORDATION CERTIFICATE
Filing Requirement of Act 74, Mich. P.A. 1970

Lucinda H. DeLaur
REGISTER OF DEEDS

For corners in:

Lake (County)	Located In:	Corner Code -#
1. Public Land Survey	T <u>17</u> N R <u>13</u> W	L-13
	T _____ R _____	_____
	T _____ R _____	_____
	T _____ R _____	_____
2. Property Controlling in Section	S _____ T _____ R _____	_____
	S _____ T _____ R _____	_____
3. Miscellaneous Property in Sec.	S _____ T _____ R _____	_____
	S _____ T _____ R _____	_____

Register of Deeds Stamp & File Number

4. Lot No. _____, Recorded Plat _____
5. Private Claims _____

	A	B	C	D	E	F	G	H	I	J	K	L	M
2	6		5		4		3		2		1		
3													
4	7		8		9		10		11		12		
5													
6	18		17		16		15		14		13		
7													
8	19		20		21		22		23		24		
9													
10	30		29		28		27		26		25		
11													
12	31		32		33		34		35		36		
13													

I, Robert L. Wetherell, in a field survey on November 10, 1993, do hereby certify that under requirements of P.A. 74, Michigan P.A. of 1970, the corner points mentioned in lines 1 and 2 above were in conformance with regulations and rules therefore as required in the current manual of survey instructions of the United States Department of the Interior, Bureau of Land Management or by a decree of a Court of Law and/or that the corner points mentioned in lines 3, 4 and 5 above were in conformance with the rules of the Michigan Board of Land Surveyors or by a Decree of a Court of Law; established, re-established, monumented, re-monumented, recovered, found as expressed below:

NOTE: Not more than 4 corners, all in the same town and range, may be recorded on this certificate.

A. Description of original monument and accessories and/or subsequent restoration:
L-13 - (1/4 Corner, Section 36, T17N, R13W, on the County Line)

1838 - John Mullett, D.S., G.L.O.
#1 10" W. Oak N23°E 40 Links
#2 16" W. Pine N53°W 50 Links

1899 - Delos Anderson, County Surveyor
#3 W. Oak N23°E 40 Links
(Old Gov't Witness)
#4 W. Oak West 45 Links
He reported distances of: 2721.84' to the SW Sec. Cor. and 2692.80' to SE Sec. Cor.

1907 - George West, Surveyor
Reported he used Delos Anderson's cor. and took the the following witnesses:
#5 8" W. Oak N66-3/4°E 39 Links
#6 9" W. Oak N88-1/2°W 45 Links
He reported distances of: 2637.36' to SW Sec. Cor. and 2685.87' to SE Sec. Cor.

(SEE OVER FOR CONTINUATION OF "A")

B. Description of corner evidence found and/or method applied in restoring or reestablishing corner:

L-13 - (1/4 Corner, Section 36, T17N, R13W, on the County Line)

I found 60d spike over rifle barrel, that was set by single proportionate distance by George Blass. Surveyor Blass was aware of Anderson's and West's corner and their measured distances. He did not find their monument or accessories and treated as a lost corner, probably because of the inconsistency of their measurements. I accepted Blass's corner. Condition of the recorded witnesses are: #1 Gone, #2 Gone, #3 Gone, #4 Gone, #5 Gone, #6 Gone, #7 Found in good condition, #8 Found in good condition, #9 Found in good condition, #10 Gone, #11 Found in good condition, #12 Found in good condition, #13 Found in good condition, #14 Found in good condition.


C. Description of monument for corner and accessories established to perpetuate locating the position of the corner:

L-13 - (1/4 Corner, Section 36, T17N, R13W, on the County Line)

Replaced old rifle barrel with 3/4" x 24" re-rod with Lake County Brass Cap and accepted as a careful and faithful re-establishment of the position of the original corner.

- 24" W. Oak N60°E 91.75' (16p nail with shiner in SE side of tree) (#5)
- 12" W. Oak S03°E 31.62' (60d spike in West side of tree) (#6)
- 14" W. Oak S60°W 64.35' (60d spike in NW side of tree) (#7)
- 10" W. Oak S60°E 39.25' (16p nail with shiner in NE side of tree) (#9)

Signed by Robert L. Wetherell Date 12-13-93
LS 24624
Surveyor's Michigan License No. _____

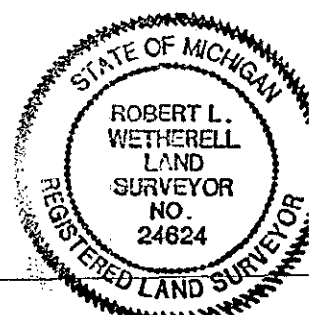

Approved by Peer Review Group December 6, 1993
Robert L. Wetherell, County Representative

CONTINUATION OF "A" - LAND CORNER RECORDATION CERTIFICATE

1951 - George Blass, LS 5489

Set Rifle Barrel

- # 7 18" W. Oak N60°E 91.75'
- # 8 8" W. Oak S03°W 31.62'
- # 9 10" W. Oak S60°W 63.69'
- #10 6" W. Oak N20°E 64.92'
- #11 6" W. Oak S60°E 39.25'

1967 - Robert Griffin, LS 13584

Found Rifle Barrel

- #12 18" W. Oak N60°E 91.75'
- #13 8" W. Oak S03°W 31.62'
- #14 10" W. Oak S60°W 63.69'

1981 - Norman Ochs, Co. Surveyor, LS 22439

Found Rifle Barrel

- #15 18" W. Oak N60°E 91.75' (#12)
- #16 8" W. Oak S03°W 31.10' (#13)
- #17 10" W. Oak S60°W 63.40' (#14)