

LAKE COUNTY REMONUMENTATION

LAND CORNER RECORDATION CERTIFICATE
Filing Requirement of Act 74, Mich. P.A. 1970

RECORDED
LAKE COUNTY, MI.
LIBER 003 PAGE 0214
DEC 13 3 43 PM '93

For corners in

Lake (County)	Located In:	Corner Code #
1. Public Land Survey	T <u>17 N</u> R <u>13 W</u>	M-13
	T _____ R _____	_____
	T _____ R _____	_____
	T _____ R _____	_____
2. Property Controlling in Section	S _____ T _____ R _____	_____
	S _____ T _____ R _____	_____
3. Miscellaneous Property in Sec.	S _____ T _____ R _____	_____
	S _____ T _____ R _____	_____

Lucinda K. Dickson
REGISTER OF DEEDS

Register of Deeds Stamp & File Number

4. Lot No. _____, Recorded Plat _____
5. Private Claims _____

	A	B	C	D	E	F	G	H	I	J	K	L	M
2	6	5	4	3	2	1							
3													
4	7	8	9	10	11	12							
5													
6	18	17	16	15	14	13							
7													
8	19	20	21	22	23	24							
9													
10	30	29	28	27	26	25							
11													
12	31	32	33	34	35	36							
13													

I, Robert L. Wetherell, in a field survey on November 10, 19 93, do hereby certify that under requirements of P.A. 74, Michigan P.A. of 1970, the corner points mentioned in lines 1 and 2 above were in conformance with regulations and rules therefore as required in the current manual of survey instructions of the United States Department of the Interior, Bureau of Land Management or by a decree of a Court of Law and/or that the corner points mentioned in lines 3, 4 and 5 above were in conformance with the rules of the Michigan Board of Land Surveyors or by a Decree of a Court of Law; established, re-established, monumented, re-monumented, recovered, found as expressed below:

NOTE: Not more than 4 corners, all in the same town and range, may be recorded on this certificate.

A. Description of original monument and accessories and/or subsequent restoration:
M-13 - (Township Corner, S.E. Corner Section 36, T17N, R13W)

1838 - John Mullett, D.S., G.L.O.
#1 27" W. Pine S12°W 22 Links
#2 10" W. Pine N69°E 39 Links

1923 - G.H. Johnson, County Surveyor
Three glass bottles for monument
#4 12" B. Oak N48°E 30'
#5 10" W. Oak S16°E 18'
#6 8" B. Oak S73°45'W 54'

1936 - W.H. Welton, USFS Forester
Three glass bottles for monument
#3 Standard Post S49°W 0.61 Chains

(SEE OVER FOR CONTINUATION OF "A" - LAND CORNER RECORDATION CERTIFICATE)

B. Description of corner evidence found and/or method applied in restoring or reestablishing corner:

M-13 - (Township Corner, S.E. Corner Section 36, T17N, R13W)

I found U.S.F.S. 5"sq. x 60" Concrete monument with Brass Cap set by R.A. Griffin. Condition of accessories are: #1 Gone, #2, Gone, #3 Gone, #4 Found 18" W. Oak that fits, #5 Gone, #6 Gone, #7 Gone, #8 Gone, #9 Found in good condition #10 Found in good condition, #11 Found in good condition, #12 Found in good condition #13 Found in good condition, #14 Found in good condition.

C. Description of monument for corner and accessories established to perpetuate locating the position of the corner:


M-13 - (Township Corner, S.E. Corner Section 36, T17N, R13W)

Accepted U.S.F.S. Concrete Monument with Brass Cap as a substantial marker for corner, and is accepted as a careful and faithful re-establishment of the position of the original corner.

- 24" B. Oak N48°E 17.55' (60d nail in NW side of tree) (#10)
- 6" B. Oak N08°W 23.71' (10" dock spike in West side of tree) (#13)
- "X" In top of 4" x 5/8" x 60" Grader Blace S45°E 49.03' (#11)
- 14" B. Oak S50°W 52.52' (60d nail in NW side of tree)

Signed by Robert L. Wetherell
LS 24624

Date 12-13-93

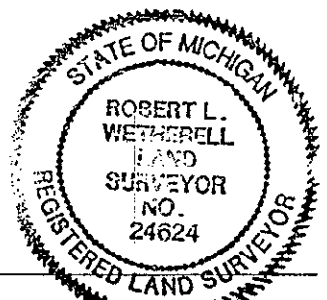

Surveyor's Michigan License No. _____

CONTINUATION OF "A" - LAND CORNER RECORDATION CERTIFICATE1951 - George Blass, LS 5489

Found 3/4" Iron Pipe with
Glass bottle around it.
7 8" B. Oak S73°45'W 54'
W. Oak S16°E 29.70'
9 Iron Fence Post East 33.4'
#10 20" B. Oak N48°E 17.50'

1966 - Robert Griffin, L.S. 13584

Found 3/4" Pipe and replaced with
5" x 36" Brass Capped concrete monument
#11 "X" in Top 4"x5/8"x60" Grader Blade S45°E 49.03'
#12 NE cor. of Fireplace S33°W 112.49'
#13 5" B. Oak N08°W 23.71'
#14 4" Pine Post North 1.8'

1981 - Norman Ochs, Co. Surveyor, LS 22439

Found Surveyor Griffin's Monument and
Accessories #10, #13 & #14, above.