

REMONUMENTATION

LAND CORNER RECORDATION CERTIFICATE
Filing Requirement of Act 74, Mich. P.A. 1970

LIBER 003 PAGE 0268

For corners in APR 06 1995

Table with columns: Lake (County), Located In, Corner Code #. Includes entries for Public Land Survey, Property Controlling in Section, Miscellaneous Property in Sec., Lot No., and Private Claims.

STATE OF MICHIGAN COUNTY OF LAKE RECORDED 14th DAY OF Nov 1894 A.D. at 11:30 AM. Register of Deeds Stamp & File Number

I, Robert L. Wetherell, in a field survey on May 25, 1994, do hereby certify that under requirements of P.A. 74, Michigan P.A. of 1970, the corner points mentioned in lines 1 and 2 above were in conformance with regulations and rules therefore as required in the current manual of survey instructions of the United States Department of the Interior, Bureau of Land Management or by a decree of a Court of Law and/or that the corner points mentioned in lines 3, 4 and 5 above were in conformance with the rules of the Michigan Board of Land Surveyors or by a Decree of a Court of Law; established, re-established, monumented, re-monumented, recovered, found as expressed below:

Grid table with columns A-M and rows 1-13. A dot is marked at the intersection of column B and row 7.

NOTE: Not more than 4 corners, all in the same town and range, may be recorded on this certificate.

A. Description of original monument and accessories and/or subsequent restoration:

B-7 - 1/4 Corner common to Sections 18 and 19, T17N, R14W, Lake Township, Lake Co., Mi.

- 1838 - John Hodgson, G.L.O. #1 - 12" Sugar N27°E 29 Links #2 - 12" Beech S44°W 22 Links
1978 - Robert L. Wetherell, L.S. 24624 Found 2-1/2" Pipe in East and West fence. S.W. cor. Sec. 18 - West 2640.20' S.E. cor. Sec. 18 - East 2631.81'
1989 - Clinton E. Cole, L.S. 17615 Used this corner to set S.1/16 cor. Sec. 18 on North and South 1/4 Line. (Lakestate Surveyors File # 5343-89)

B. Description of corner evidence found and/or method applied in restoring or reestablishing corner:

B-7 - 1/4 Corner common to Sections 18 and 19, T17N, R14W, Lake Township, Lake Co., Mi.

I found a 2-1/2" pipe, 24" long on the East side of a stone pile in a fence and tree line to the West. Corner is 3 feet West of a two-track road and 2 feet West of an old fence corner post (broken off). I also found Surveyor Cole's 1/16 corner to the North which measured 1325.48 feet. Condition of the accessories are as follows: #1 Gone, #2 Gone.

RATIFIED BY THE LAKE CO. PEER REVIEW GROUP IN ACCORDANCE WITH P.A. 345 CHAIRMAN [Signature] DATE 11/8/94

C. Description of monument for corner and accessories established to perpetuate locating the position of the corner:


B-7 - 1/4 Corner common to Sections 18 and 19, T17N, R14W, Lake Township, Lake Co., Mi.

I replaced the 2-1/2" pipe with a 3/4" x 24" re-bar with Lake County Brass Cap, and is accepted as a careful and faithful re-establishment of the position of the original corner.

- 15" Elm S39°W 269.59' (60d spike in S.E. side of tree)
13" Elm N84°W 69.89' (60d spike in N. side of tree)
14" Maple S16°W 253.21' (60d spike in W. side of tree)
7" Maple S9°E 345.61' (60d spike in E. side of tree)

Signed by Robert L. Wetherell 24624

Date 11/9/94

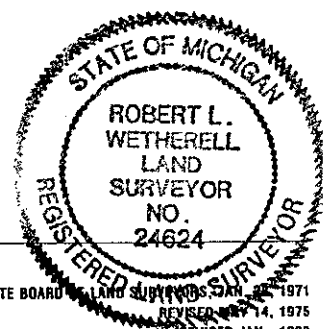

Surveyor's Michigan License No.