

MAY 16 1997

LAND CORNER RECORDATION CERTIFICATE
Filing Requirement of Act 74, Mich. P.A. 1970

LIBER 003 PAGE 0387

For corners in

Lake (County)	Located In:	Corner Code #
1. Public Land Survey	T 17N R 14W	C-6
	T _____ R _____	_____
	T _____ R _____	_____
	T _____ R _____	_____
2. Property Controlling in Section	S _____ T _____ R _____	_____
	S _____ T _____ R _____	_____
3. Miscellaneous Property in Sec.	S _____ T _____ R _____	_____
	S _____ T _____ R _____	_____

RECORDED
LAKE COUNTY, MI.
NOV 14 11 25 AM '96
REGISTER OF DEEDS
REGISTER OF DEEDS Stamp & File Number

- 4. Lot No. _____, Recorded Plat _____
- 5. Private Claims _____

	A	B	C	D	E	F	G	H	I	J	K	L	M
2	6		5		4		3		2		1		
3													
4	7		8		9		10		11		12		
5													
6	18		17		16		15		14		13		
7													
8	19		20		21		22		23		24		
9													
10	30		29		28		27		26		25		
11													
12	31		32		33		34		35		36		
13													

I, Robert L. Wetherell, in a field survey on July 31, 1996, do hereby certify that under requirements of P.A. 74, Michigan P.A. of 1970, the corner points mentioned in lines 1 and 2 above were in conformance with regulations and rules therefore as required in the current manual of survey instructions of the United States Department of the Interior, Bureau of Land Management or by a decree of a Court of Law and/or that the corner points mentioned in lines 3, 4 and 5 above were in conformance with the rules of the Michigan Board of Land Surveyors or by a Decree of a Court of Law; established, re-established, monumented, re-monumented, recovered, found as expressed below:

NOTE: Not more than 4 corners, all in the same town and range, may be recorded on this certificate.

A. Description of original monument and accessories and/or subsequent restoration:
C-6 - 1/4 Corner common to Sections 17 & 18 T17N, R14W, Lake Twp., Lake Co., Mi.

1838 - John Hodgson, G.L.O.

Set Wood Post

#1 - 8" Hemlock N84°W 36 Links (23.76')

#2 - 12" Hemlock S28°E 32 Links (21.12')

#3 - 10 Links Stream - South 8.5 Chains

1915 - George Johnson, County Surveyor

Stone for Corner

#4 - 5" Cherry S88°30'E 33'

1978 - Robert L. Wetherell, LS 24624

Set 1/2" Re-bar in centerline of gravel

road and in fence line East and West

Survey recorded in Liber 2, Page 320.

#5 - 6" Poplar N40°E 46.93'

#6 - 8" Sassafras N41°W 41.00'

#7 - 4" Cherry S78°W 27.13'

Distance from S.E. cor. to E.1/4 cor.

2611.80'

1992 - Sammy Barnett, LS 16923

Found 1/2" Rebar bent.

Distance from S.E. cor. to

E.1/4 cor. 2611.93'

B. Description of corner evidence found and/or method applied in restoring or reestablishing corner:

C-6 - 1/4 Corner common to Sections 17 & 18 T17N, R14W, Lake Twp., Lake Co., Mi.

I found a 1/2" Re-bar in centerline of gravel road North and South and fences East and West. I searched for other irons or markers or any other evidence, but found nothing to dispute this location for the 1/4 corner.

Condition of the accessories are as follows: #1 Gone, #2 Gone, #3 Measured 535', #4 Gone, #5 Found in good condition, #6 Found in good condition, #7 Found dead.

RATIFIED BY THE LAKE CO. PEER REVIEW GROUP
 IN ACCORDANCE WITH P.A. 345
 CHAIRMAN R. J. W.
 DATE 11-12-96

C. Description of monument for corner and accessories established to perpetuate locating the position of the corner:

C-6 - 1/4 Corner common to Sections 17 & 18 T17N, R14W, Lake Twp., Lake Co., Mi.


I replaced the 1/2" Re-bar with a 3/4" x 24" with a Lake County Brass Cap, and is accepted as a careful and faithful re-establishment of the position of the original corner.

13" Poplar N30°E 45.85' (60d spike in N.W. side) #5

10" Forked Wild Cherry N44°W 65.34' (60d spike in S.W. side)

5" Black Locust S60°W 36.98' (60d spike in S.E. side)

15" W. Pine S10°E 149.77' (60d spike in N.E. side)

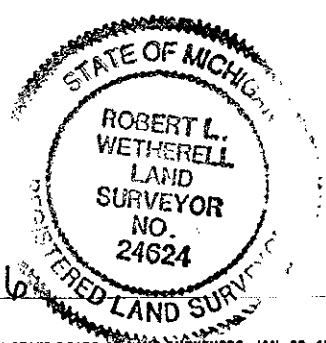

Signed by Robert L. Wetherell
 24624

Date 11-13-1996

Surveyor's Michigan License No. _____