

MAY 1 8 1997

CONFIDENTIAL

LAND CORNER RECORDATION CERTIFICATE
Filing Requirement of Act 74, Mich. P.A. 1970

LIBER 003 PAGE 0388


For corners in

Table with columns: LAKE (County), Located In: (17N, 14W), Corner Code # (C-7). Rows include Public Land Survey, Property Controlling in Section, and Miscellaneous Property in Sec.

RECORDED LAKE COUNTY, MI.
REGISTER OF DEEDS
Nov 14 11 25 AM '96

Register of Deeds Stamp & File Number

- 4. Lot No.
5. Private Claims

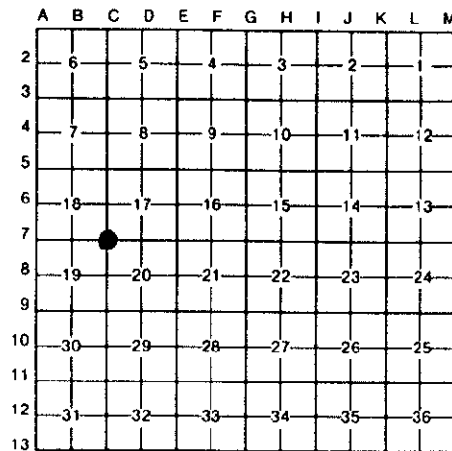

I, Robert L. Wetherell, in a field survey on July 31, 1996, do hereby certify that under requirements of P.A. 74, Michigan P.A. of 1970, the corner points mentioned in lines 1 and 2 above were in conformance with regulations and rules therefore as required in the current manual of survey instructions of the United States Department of the Interior, Bureau of Land Management or by a decree of a Court of Law and/or that the corner points mentioned in lines 3, 4 and 5 above were in conformance with the rules of the Michigan Board of Land Surveyors or by a Decree of a Court of Law, established, re-established, monumented, re-monumented, recovered, found as expressed below:

NOTE: Not more than 4 corners, all in the same town and range, may be recorded on this certificate.

A. Description of original monument and accessories and/or subsequent restoration:

C-7 - Section corner common to Sections 17, 18, 19 & 20, T17N, R14W, Lake Twp., Lake Co., Mi.

1838 - John Hodgson, G.L.O.

Set wood post

#1 - 18" Pine N63°W 16 Links (10.56')

#2 - 14" Pine S53°E 10 Links (6.60')

1945 - George Blass, LS 5489

Found wood stake with stones from old witnesses. Set new stake with stones

#3 - 8" B. Oak N68°W 12.02'

#4 - 10" B. Oak N36°W 13.20'

#5 - 24" W. Oak N3°E 54.20'

#6 - U.S.F.S. Marker S63°E 56.10'

1967 - Robert Griffin, LS 13584

Found wood stake. Set 5" x 5' concrete post.

#7 - 11" R. Pine S3°W 54.23'

#4 - 14" R. Oak N36°W 13.54'

#8 - 4" x 7' Post (no distance)

#9 - 8" R. Oak N72°E 82.62'

1978 - Robert Wetherell, LS 24624

Survey recorded in L. 02, Pg. 320.

B. Description of corner evidence found and/or method applied in restoring or reestablishing corner:

C-7 - Section corner common to Sections 17, 18, 19 & 20, T17N, R14W, Lake Twp., Lake Co., Mi.

I found the 5" x 5' Concrete monument set by Robert Griffin. I searched for other irons or markers but found nothing to dispute this location.

Condition of the accessories are as follows: #1 Gone, #2 gone, #3 Found in good condition, #4 Found in good condition, #5 Found in good condition, #6 Gone, #7 Found in good condition, #8 Found in good condition, (1.10' North) #9 Found in good condition.

RATIFIED BY THE LAKE CO. PEER REVIEW GROUP IN ACCORDANCE WITH P.A. 345

CHAIRMAN R.L.W. DATE 11-12-96

C. Description of monument for corner and accessories established to perpetuate locating the position of the corner:

C-7 - Section corner common to Sections 17, 18, 19 & 20, T17N, R14W, Lake Twp., Lake Co., Mi.

I accepted the 5" x 5' Concrete Monument as a substantial maker for the corner, and is accepted as a careful and faithful re-establishment of the position of the original corner.

- 14" R. Oak N68°W 12.15' (10" dock spike in N.E. side) #3
13" R. Pine S3°W 54.23' (10" dock spike in W. side) #7
18" R. Oak N36°W 13.54' (10" dock spike in E. side) #4
14" R. Oak N72°E 82.62' (10" dock spike in S. side) #9

Signed by Robert L. Wetherell Date 11-13-1996

Surveyor's Michigan License No. 24624

