

**SURVEY & REMONUMENTATION**

NOV 15 1993 LAKE COUNTY REMONUMENTATION

LIBER 003 PAGE 0179

COMMISSION

**LAND CORNER RECORDATION CERTIFICATE**  
Filing Requirement of Act 74, Mich. P.A. 1970

For corners in Lake \_\_\_\_\_

Located In: \_\_\_\_\_ Corner Code # \_\_\_\_\_

1. Public Land Survey	T 17N	R 14W	C-13
	T	R	
	T	R	
	T	R	
2. Property Controlling in Section	S	T	R
	S	T	R
3. Miscellaneous Property in Sec.	S	T	R
	S	T	R

RECORDED  
LAKE COUNTY, MI.  
NOV 03 40 PM '93  
REGISTER OF DEEDS  
*Joseph M. Brown*

Register of Deeds Stamp & File Number

4. Lot No. \_\_\_\_\_, Recorded Plat \_\_\_\_\_  
5. Private Claims \_\_\_\_\_

	A	B	C	D	E	F	G	H	I	J	K	L	M
2	6	5	4	3	2	1							
3													
4	7	8	9	10	11	12							
5													
6	18	17	16	15	14	13							
7													
8	19	20	21	22	23	24							
9													
10	30	29	28	27	26	25							
11													
12	31	32	33	34	35	36							
13													

I, Robert L. Wetherell, in a field survey on October 26, 19 93, do hereby certify that under requirements of P.A. 74, Michigan P.A. of 1970, the corner points mentioned in lines 1 and 2 above were in conformance with regulations and rules therefore as required in the current manual of survey instructions of the United States Department of the Interior, Bureau of Land Management or by a decree of a Court of Law and/or that the corner points mentioned in lines 3, 4 and 5 above were in conformance with the rules of the Michigan Board of Land Surveyors or by a Decree of a Court of Law; established, re-established, monumented, re-monumented, recovered, found as expressed below:

**NOTE: Not more than 4 corners, all in the same town and range, may be recorded on this certificate.**

A. Description of original monument and accessories and/or subsequent restoration:  
C-13 (Section corner Sections 32 & 31 on the county line, T17N, R14W)

GLO Re-survey 1856 by Thomas Whelpley  
#1 30" Nor. Pine S62 1/2°E 52 Links  
#2 12" W. Oak N68 1/2°E 10 Links  
#3 18" Nor. Pine N64°W 55 Links  
#4 20" Nor. Pine S52 1/2°W 135 Links

1967 by R. A. Griffin, L.S. 13584  
#5 4" Sq. x 7' Pine Post N45°E 46.7'  
#6 6" W. Pine N55°E 59.32'  
#7 5" W. Oak S61°W 78.84'  
#8 7" W. Oak N45°W 57.98'

B. Description of corner evidence found and/or method applied in restoring or reestablishing corner:  
C-13 (Section corner Sections 32 & 31 on the county line, T17N, R14W)

R. A. Griffin in 1968 found a railroad rail splice plate in the intersection North-South and East-West roads. Due to lack of contrary evidence Griffin presumed that the splice plate marked the true corner. South 1/4 corner of Section 32 measures at 2636.70'.

Griffin replaced splice plate with 5" Sq. x 36" Concrete Monument with brass cap set 1' below road surface (recorded in Liber 01, Page 18), NOTE: Monument is now 3.2' below road surface. Found Concrete Monument in good condition. Condition of recorded witnesses is: #1 Gone; #2 Gone; #3 Gone; #4 Gone; #5 Found in good condition; #6 Found in good condition; #7 Gone; #8 Found in good condition.

C. Description of monument for corner and accessories established to perpetuate locating the position of the corner:  
C-13 (Section corner Sections 32 & 31 on the county line, T17N, R14W)


Accepted R. A. Griffin's Concrete Monument with brass cap as a substantial marker for the Section corner, and is accepted as a careful and faithful re-establishment of the position of the original corner.

9" W. Pine N55°E 59.32' (10" dock spike in S.E. side of tree) (#6)  
10" W. Oak N45°W 57.98' (10" dock spike in N.W. side of tree) (#8)  
18"-12" Tw. B. Oak S33°E 89.60' (60d. nail in N.E. side of tree)  
14" B. Oak S42°W 84.70' (60d. nail in N.W. side of tree)  
4" Sq. x 7' Pine Post N45°E 46.53' (#5)

Signed by Robert L. Wetherell

Date 11-5-93

Surveyor's Michigan License No. LS 24624

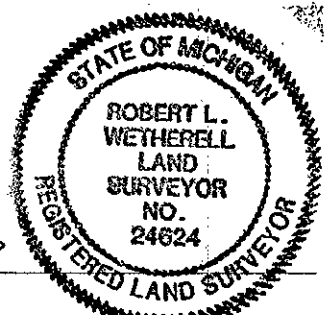

Approved by Peer Review Group Octoberr 27, 1993  
Robert L. Wetherell, County Representative

*RLW*