

SURVEY & REMONUMENTATION

NOV 15 1993

COMMISSION

LAKE COUNTY REMONUMENTATION

LAND CORNER RECORDATION CERTIFICATE

Filing Requirement of Act 74, Mich. P.A. 1970

LIBER 003 PAGE 0181

For corners in LAKE

(County)	Located In:	Corner Code --#
1. Public Land Survey	T 17N R 14W	E-13
	T R	
	T R	
	T R	
2. Property Controlling in Section	S T R	
	S T R	
3. Miscellaneous Property in Sec.	S T R	
	S T R	

RECORDED
LAKE COUNTY, MI.
NOV 03 40 PM '93
REGISTER OF DEEDS
Register of Deeds Stamp & File Number

4. Lot No. _____, Recorded Plat _____
5. Private Claims _____

	A	B	C	D	E	F	G	H	I	J	K	L	M
2	6		5		4		3		2		1		
3													
4	7		8		9		10		11		12		
5													
6	18		17		16		15		14		13		
7													
8	19		20		21		22		23		24		
9													
10	30		29		28		27		26		25		
11													
12	31		32		33		34		35		36		
13													

I, Robert L. Wetherell, in a field survey on October 26, 1993, do hereby certify that under requirements of P.A. 74, Michigan P.A. of 1970, the corner points mentioned in lines 1 and 2 above were in conformance with regulations and rules therefore as required in the current manual of survey instructions of the United States Department of the Interior, Bureau of Land Management or by a decree of a Court of Law and/or that the corner points mentioned in lines 3, 4 and 5 above were in conformance with the rules of the Michigan Board of Land Surveyors or by a Decree of a Court of Law; established, re-established, monumented, re-monumented, recovered, found as expressed below:

NOTE: Not more than 4 corners, all in the same town and range, may be recorded on this certificate.

A. Description of original monument and accessories and/or subsequent restoration:

E-13 (Section corner Section's 33 & 32 on the county line, T17N, R14W)

GLO Re-survey 1856 by Thomas Whelpley
 #1 14" W. Pine S30°W 53 Links
 #2 14" Nor. Pine S13 3/4°E 30 Links
 #3 12" Nor. Pine N65 3/4°E 30 Links
 #4 24" Nor. Pine N22 1/2°W 42 Links

Undated (1920's) Survey by G. H. Johnson, County Surveyor
 Called for pipe as monument
 #5 8" B. Oak S.W. 42'

1967 by R. A. Griffin, LS 13584
 #6 4" Sq. x 7' Pine Post N45°E 46.7'
 #7 8" W. Oak N46°E 99.72'
 #8 7" W. Oak S41°W 92.85'
 #9 4" W. Pine N44°W 52.60'

B. Description of corner evidence found and/or method applied in restoring or reestablishing corner:

E-13 (Section corner Section's 33 & 32 on the county line, T17N, R14W)

R. A. Griffin found 1-1/4" x 24" Iron Pipe in 1967, replaced with 5" Sq. x 36" concrete Monument with brass cap (recorded in Liber 1, Page 29). Found Giffin's Concrete Monument in good condition. Condition of recorded witnesses is: #1 Gone; #2 Gone; #3 Gone; #4 Gone; #5 Found Stump; #6 Found in good condition; #7 Found in good condition; #8 Found in good condition; #9 Found in good condition.


C. Description of monument for corner and accessories established to perpetuate locating the position of the corner:

E-13 (Section corner Section's 33 & 32 on the county line, T17N, R14W)

Accepted R. A. Griffin's Concrete Monument with brass cap as a substantial marker for the section corner and is accepted as a careful and faithful reestablishment of the position of the original corner:

8" W. Oak N46°E 99.72' (10" dock spike in N.W. side of tree) (#7)
 7" W. Oak S41°W 92.85' (10" dock spike in S.E. side of tree) (#8)
 4" W. Pine N44°W 52.60' (10" dock spike in S.W. side of tree) (#9)
 6" W. Pine S43°E 65.15' (60d. nail in N.E. side of tree)
 4" Sq. x 7' Pine Post N45°E 46.7' (#6)

Signed by Robert L. Wetherell Date 11-5-93
 LS 24624
 Surveyor's Michigan License No. _____

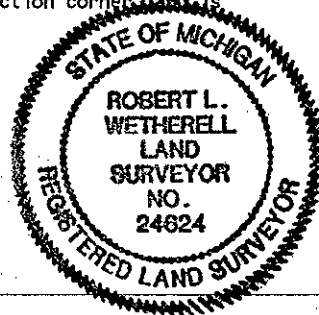

Approved by Peer Review Group October 27, 1993
 Robert L. Wetherell, County Representative R.L.W.