SURVEY & REMONUMENTATION

NOV 1 5 1993

COMMISSION

LAKE COUNTY REMONUMENTATION

LAND CORNER RECORDATION CERTIFICATE

Filing Requirement of Act 74, Mich. P.A. 1970

LIBER 003 PAGE 0183

For corners in LAKE (County)

	Located In:	Corner Code #
1. Public Land Survey	T 17N R 14W	G-13
	T ___ R ___	
	T ___ R ___	
	T ___ R ___	
2. Property Controlling in Section	S ___ T ___ R ___	
	S ___ T ___ R ___	
3. Miscellaneous Property in Sec.	S ___ T ___ R ___	
	S ___ T ___ R ___	

RECORDED LAKE COUNTY, MI. Nov 8 3 41 PM '93 REGISTER OF DEEDS

Register of Deeds Stamp & File Number

4. Lot No. _____, Recorded Plat _____
5. Private Claims _____

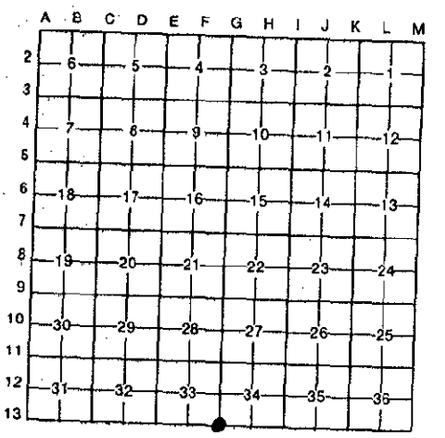

I, Robert L. Wetherell, in a field survey on October 26, 19 93, do hereby certify that under requirements of P.A. 74, Michigan P.A. of 1970, the corner points mentioned in lines 1 and 2 above were in conformance with regulations and rules therefore as required in the current manual of survey instructions of the United States Department of the Interior, Bureau of Land Management or by a decree of a Court of Law and/or that the corner points mentioned in lines 3, 4 and 5 above were in conformance with the rules of the Michigan Board of Land Surveyors or by a Decree of a Court of Law; established, re-established, monumented, re-monumented, recovered, found as expressed below:

NOTE: Not more than 4 corners, all in the same town and range, may be recorded on this certificate.

A. Description of original monument and accessories and/or subsequent restoration:

G-13 (Section corners, Sections 33 & 34 on the county line, T17, R14W)

GLO Re-survey 1856 by Thomas Whelpley
#1 18" Nor. Pine N 17°W 9 Links
#2 20" W. Pine S06°W 20 Links
#3 14" W. Pine N65 3/4°E 81 Links
#4 W. Pine S38 1/2°E 40 Links

1917 by Theordore Norlin, Sur.
#5 8" B. Oak N37°E 58.4'
#6 10" B. Oak S47°E 81.5'

Undated Survey (1920's) by G.H. Johnson, Co. Surveyor
#7 10" B. Oak N39 1/2°E 58.5' (#5)

1952 by G.M. Blass, LS 5489
Called for Iron Pipe as Monument
#8 8" W. Oak S02°E 49.20'
#9 8" W. Oak N41°W 70.60'
#10 18" B. Oak N37°E 57.95' (#5)

1968 by R.A. Griffin, LS 13584
#11 4" Sq. x 7' Pine Post S45°E 46.75'
#12 6" R. Pine S45°E 105.81'
#13 4" R. Pine S45°W 100.50'
#14 8" W. Oak N44°W 70.95' (#9)
#15 8" W. Oak N21°E 68.87'

B. Description of corner evidence found and/or method applied in restoring or reestablishing corner:

G-13 (Section corners, Sections 33 & 34 on the county line, T17, R14W)
In 1968, R.A. Griffin found 1" x 24" Iron Pipe by Surveyor's Norlin and Blass, replaced with a 5" Sq. x 36" Concrete monument with Brass Cap (recorded in Liber 1, Page 39). Found Griffin's Concrete Monument in good condition. Condition of recorded witnesses is: #1 gone; #2 Gone; #3 Gone; #4 Gone; #5; Found Stump; #6 Found Stump; #7 Same as #5; #8 Found in good condition; #9 Found in good condition; #10 Same as #5 & #7; #11 Found in good condition; #12 Found in good condition; #13 Found in good condition; #14 Same as #9; #15 Found in good condition.

C. Description of monument for corner and accessories established to perpetuate locating the position of the corner:

G-13 (Section corners, Sections 33 & 34 on the county line, T17, R14W)
Accepted R.A. Griffin's Concrete Monument with brass cap as a substantial marker for the section corner. And is accepted as a careful and faithful reestablishment of the position of the original corner.

9" R. Pine S45°E 105.81' (10" dock spike in S.W. side of tree) (#12)
7" R. Pine S45°W 100.50' (10" dock spike in S.E. side of tree) (#13)
11" W. Oak N44°W 70.95' (60d. nail above shiner in N.E. side of tree) (#14)
11" W. Oak N21°E 68.87' (10" dock spike in S.E. side of tree) (#14)
4" Sq. x 7' Pine Post S45°E 46.75' (#15)

STATE OF MICHIGAN ROBERT L. WETHERELL LAND SURVEYOR NO. 24624 REGISTERED LAND SURVEYOR

Signed by Robert L. Wetherell Date 11-5-93

Surveyor's Michigan License No. LS 24624

Approved by Peer Review Group October 27, 1993
Robert L. Wetherell, County Representative RLW.

FORM APPROVED BY MICHIGAN STATE BOARD OF LAND SURVEYORS, JAN. 28, 1971
REVISED MAY 14, 1975
REVISED JAN., 1983