

NOV 15 1993

LAKE COUNTY REMONUMENTATION

COMMISSION

LAND CORNER RECORDATION CERTIFICATE

Filing Requirement of Act 74, Mich. P.A. 1970

LIBER 003 PAGE 0184

For corners in LAKE

(County)	Located In:	Corner Code #
1. Public Land Survey	T <u>17N</u> R <u>14W</u>	<u>H-13</u>
	T _____ R _____	_____
	T _____ R _____	_____
	T _____ R _____	_____
2. Property Controlling in Section	S _____ T _____ R _____	_____
	S _____ T _____ R _____	_____
3. Miscellaneous Property in Sec.	S _____ T _____ R _____	_____
	S _____ T _____ R _____	_____

REGISTER OF DEEDS
 Nov 8 3 41 PM '93
 RECORDED
 LAKE COUNTY, MI.

Register of Deeds Stamp & File Number

4. Lot No. _____, Recorded Plat _____
 5. Private Claims _____

	A	B	C	D	E	F	G	H	I	J	K	L	M
2	6	5	4	3	2	1							
3													
4	7	8	9	10	11	12							
5													
6	18	17	16	15	14	13							
7													
8	19	20	21	22	23	24							
9													
10	30	29	28	27	26	25							
11													
12	31	32	33	34	35	36							
13													

I, Robert L. Wetherell, in a field survey on October 25, 1993, do hereby certify that under requirements of P.A. 74, Michigan P.A. of 1970, the corner points mentioned in lines 1 and 2 above were in conformance with regulations and rules therefore as required in the current manual of survey instructions of the United States Department of the Interior, Bureau of Land Management or by a decree of a Court of Law and/or that the corner points mentioned in lines 3, 4 and 5 above were in conformance with the rules of the Michigan Board of Land Surveyors or by a Decree of a Court of Law; established, re-established, monumented, re-monumented, recovered, found as expressed below:

NOTE: Not more than 4 corners, all in the same town and range, may be recorded on this certificate.

A. Description of original monument and accessories and/or subsequent restoration:

H-13 (1/4 Corner Section 34 on the county line, T17N, R14W)

GLO Re-survey 1856 by Thomas Whelpley
 #1 8" Pitch Pine N21°W 33 Links
 #2 10" Pitch Pine S55-1/4°E 73 Links

1925 by G. H. Johnson,
County Surveyor

1917 by Theodore Norlin, Surveyor
 Called for Iron Pipe as Monument
 #3 12" W. Oak N39°E 71.0'

Recorded Plat of
 Pine Grove Beach
 3/4" x 20" Iron for Monument

#4 6" Pine N51°W 76.10'

1965 by G.M. Blass, LS 5489
 Found Iron Pipe by Norlin and replaced with Concrete Monument
 #5 4" x 36" Concrete Monument
 33.0' North
 #6 18" W. Oak N40°E 76.05'
 #7 4" R. Pine S43°E 38.12'
 #8 8" W. Oak N24°W 45.66'
 (SEE OVER FOR CONTINUATION OF "A")

B. Description of corner evidence found and/or method applied in restoring or reestablishing corner:

H-13 (1/4 Corner Section 34 on the county line, T17N, R14W)

Found 4" dia. x 36" Concrete Monument with brass cap set by G.M. Blass in good condition. Condition of recorded witnesses is: #1 Gone; #2 Gone; #3 Gone; #4 Gone; #5 Found in good condition; #6 Tree down found stump; #7 Found in good condition; #8 Gone; #9 Same as #5; #10 Same as #7; #11 Found in good condition; #12 Found in good condition.


C. Description of monument for corner and accessories established to perpetuate locating the position of the corner:

H-13 (1/4 Corner Section 34 on the county line, T17N, R14W)

Accepted Blass's Concrete Monument with brass cap as a substantial marker for the 1/4 corner, and is accepted as a careful and faithful reestablishment of the original corner.

Center of Iron in Concrete Monument 33.00' North
 5" R. Pine S41°E 38.33' (60d. nail in N.E. side of tree) (#10)
 7" R. Pine S32°W 60.30' (10" dock spike in S.E. side of tree) (#11)
 12" B. Oak N52°W 55.88' (60d. nail N.E. side of tree)
 4" Sq. x 7' Pine Post 33.0' South (#12)

Signed by Robert L. Wetherell Date 11-5-93
 Surveyor's Michigan License No. LS 24624

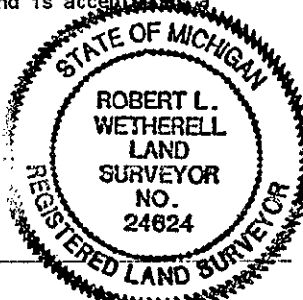

Approved by Peer Review Group October 27, 1993
 Robert L. Wetherell, County Representative

RLW

1968 by R.A. Griffin, LS 13584

Recorded in Liber 1, Page 39

9 Center of Iron in Concrete

Plat Monument 33.0' North

#10 5" R. Pine S41°E 38.33'

#11 5" R. Pine S32°W 60.30'

#12 4" Sq. x 7' Pine Post

33' South