

NOV 21 1997

COMMISSION

LAND CORNER RECORDATION CERTIFICATE
Filing Requirement of Act 74, Mich. P.A. 1970

RECORDED LAKE COUNTY, MI. LIBER 004 PAGE 0043 SEP 12 10 31 AM '97

REGISTER OF DEEDS

For corners in

Table with columns: Lake (County), Located In: (17N, 14W), Corner Code # (I-4). Rows include Public Land Survey, Property Controlling in Section, Miscellaneous Property in Sec.

Register of Deeds Stamp & File Number

- 4. Lot No. , Recorded Plat
5. Private Claims

Robert L. Wetherell July 2, 97

I, Robert L. Wetherell, in a field survey on July 2, 1997, do hereby certify that under requirements of P.A. 74, Michigan P.A. of 1970, the corner points mentioned in lines 1 and 2 above were in conformance with regulations and rules therefore as required in the current manual of survey instructions of the United States Department of the Interior, Bureau of Land Management or by a decree of a Court of Law and/or that the corner points mentioned in lines 3, 4 and 5 above were in conformance with the rules of the Michigan Board of Land Surveyors or by a Decree of a Court of Law; established, re-established, monumented, re-monumented, recovered, found as expressed below:

NOTE: Not more than 4 corners, all in the same town and range, may be recorded on this certificate.

Grid table with columns A-M and rows 2-13. A dot is marked at the intersection of column J and row 4.

A. Description of original monument and accessories and/or subsequent restoration:

I-4 - 1/4 Corner common to Sections 10 and 11, T17N, R14W, Lake Co., Mi.

- 1838 - J. Hodgson, G.L.O. 1977 - Robert Griffin, LS 13584 1986 - Clinton E. Cole, LS 17615
#1 - 6" Aspen N19°W 26 Links L.C.R.C. - Liber 02, Pg. 316 U.S.F.S. Concrete Monument
#2 - 6" Aspen S50°E 10 Links Found 3/4" Iron & Johnson's witness. Survey recorded in Liber 03, Pg. 66
1915 - George Johnson, Co. Sur. Replaced with 5" x 60" Conc. Mon. Same witnesses as Griffin's
3/4" Iron 3 Feet Long #4 - 6" W. Pine S15°W 88.97'
#3 - 16" Elm S55°E 57' #5 - 6" Maple S39°W 37.30'
#6 - Post - north 1.6'

B. Description of corner evidence found and/or method applied in restoring or reestablishing corner:

I-4 - 1/4 Corner common to Sections 10 and 11, T17N, R14W, Lake Co., Mi.

Found U.S.F.S. 5" Square Concrete Monument on West edge of Swamp.

Condition of the accessories are as follows: #1 Gone, #2 Gone, #3 Gone, #4 Found in good condition, #5 Found in good condition, #6 Found in good condition,

RATIFIED BY THE LAKE CO. PEER REVIEW GROUP IN ACCORDANCE WITH P.A. 345


CHAIRMAN R.L.W. DATE 8-27-97

C. Description of monument for corner and accessories established to perpetuate locating the position of the corner:

I-4 - 1/4 Corner common to Sections 10 and 11, T17N, R14W, Lake Co., Mi.

I accepted the 5" Square Concrete Monument as a substantial marker for the corner, and is accepted as a careful and faithful re-establishment of the position of the original corner.

- 9" Tw. Maple N36°W 34.20' (60d spike in E. side)
22" W. Pine N27°E 42.30' (60d spike in E. side)
14" Maple S44°W 37.37' (dock spike in S.E. side) #5
12" W. Pine S20°W 88.95' (dock spike in E. side) #4

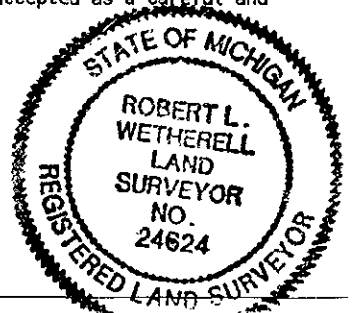

Signed by Robert L. Wetherell

Date 8-27-97

Surveyor's Michigan License No.