

MEMORANDUM

NOV 21 1997

COMMISSIONER

LAND CORNER RECORDATION CERTIFICATE
Filing Requirement of Act 74, Mich. P.A. 1970

RECORDED
LAKE COUNTY, MI.
LIBER 004 PAGE 0044

SEP 12 10 32 AM '97

For corners in

Lake (County)	Located In:		Corner Code #
	17N	14W	
1. Public Land Survey	T	R	I-5
	T	R	
	T	R	
	T	R	
2. Property Controlling in Section	S	T	R
	S	T	R
3. Miscellaneous Property in Sec.	S	T	R
	S	T	R

REGISTER OF DEEDS

Register of Deeds Stamp & File Number

- 4. Lot No. _____, Recorded Plat _____
- 5. Private Claims _____

	A	B	C	D	E	F	G	H	I	J	K	L	M
2	6	5	4	3	2	1							
3													
4	7	8	9	10	11	12							
5													
6	18	17	16	15	14	13							
7													
8	19	20	21	22	23	24							
9													
10	30	29	28	27	26	25							
11													
12	31	32	33	34	35	36							
13													

Robert L. Wetherell July 2, 1997

I, _____, in a field survey on _____, 19____, do hereby certify that under requirements of P.A. 74, Michigan P.A. of 1970, the cornerpoints mentioned in lines 1 and 2 above were in conformance with regulations and rules therefore as required in the current manual of survey instructions of the United States Department of the Interior, Bureau of Land Management or by a decree of a Court of Law and/or that the corner points mentioned in lines 3, 4 and 5 above were in conformance with the rules of the Michigan Board of Land Surveyors or by a Decree of a Court of Law; established, re-established, monumented, re-monumented, recovered, found as expressed below:

NOTE: Not more than 4 corners, all in the same town and range, may be recorded on this certificate.

A. Description of original monument and accessories and/or subsequent restoration:

I-5 - Section Corner common to Sections 10, 11, 14 & 15, T17N, R14W, Lake Co., Mi.

1838 - John Hodgson, G.L.O.

#1 - 12" W. Oak N66°E 60 Links

#2 - 24" Pine S74°W 68 Links

1916 - D.W. O'Neals - Plat of "Silver Lakes"

#3 - 14" W. Oak Stump N52°10'W 31.98'

#4 - 14" W. Oak Stump S72°20'W 13.10'

1948 - K.E. Tripp, C.E.

Measured 2641.73 feet from this corner South to the 1/4 corner common to Sections 14 & 15.

(SEE OVER FOR CONTINUATION OF "A")

B. Description of corner evidence found and/or method applied in restoring or reestablishing corner:

I-5 - Section Corner common to Sections 10, 11, 14 & 15, T17N, R14W, Lake Co., Mi.

I found the 5" Square Concrete Monument by Griffin in the center of a North and South dirt road.

Condition of the accessories are as follows: #1 Gone, #2 Gone, #3 Gone, #4 Gone, #5 Found in good condition, #6 Found in good condition, #7 Found in good condition, #8 Found in good condition, #9 Gone.

I measured 2639.96 feet South to the 1/4 corner common to Sections 14 and 15 consistent with K.E. Tripp's measurement.

ATIFIED BY THE LAKE CO. PEER REVIEW GROUP
IN ACCORDANCE WITH P.A. 345

CHAIRMAN R.L.W.

DATE 8-27-97

C. Description of monument for corner and accessories established to perpetuate locating the position of the corner:

I-5 - Section Corner common to Sections 10, 11, 14 & 15, T17N, R14W, Lake Co., Mi.


I accepted the 5" Square Concrete Monument as a substantial marker for the corner, and is accepted as a careful and faithful re-establishment of the position of the original corner.

9" W. Oak S50°E 66.81' (dock spike in S.W. side) #6

9" W. Oak S46°W 51.23' (dock spike in S.E. side) #7

10" R. Oak N75°W 41.43' (dock spike in N. side) #8

14" R. Oak N48°E 73.37' (dock spike in S. side) #5

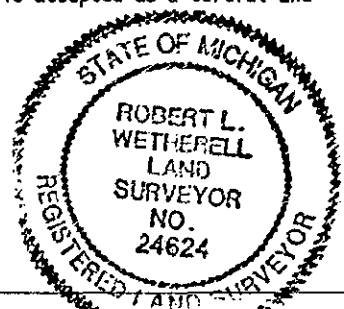

Signed by Robert L. Wetherell

Date 8-27-97

Surveyor's Michigan License No. _____

A-44A

CONTINUATION OF "A" - DESCRIPTION OF ORIGINAL MONUMENT AND ACCESSORIES AND/OR SUBSEQUENT RESTORATION:

1969 - Robert Griffin, LS 13584

L.C.R.C. Liber 01, Pg. 45

Found the Iron Pipe from the plat
of "Silver Lakes". It had been
removed from its proper location
by the Lake County Road Commission.
Reset the corner from recovered plat
Monuments. South and West
(1533' & 523' respectively)

Set 5" Concrete Monument

#5 - 8" Red Oak N47°E 73.34'

#6 - 5" W. Oak S55°E 66.83'

#7 - 6" W. Oak S42°W 51.17'

#8 - 5" R. Oak N80°W 41.44'

#9 - 4" Post - West 32.88'