

NOV 15 1993

LAKE COUNTY REMONUMENTATION

LIBER 003 PAGE 0186

COMMISSION

LAND CORNER RECORDATION CERTIFICATE

Filing Requirement of Act 74, Mich. P.A. 1970

For corners in LAKE

(County)	Located In:	Corner Code #
1. Public Land Survey	T 17N R 14W	I-13
	T R	
	T R	
	T R	
2. Property Controlling in Section	S T R	
	S T R	
3. Miscellaneous Property in Sec.	S T R	
	S T R	

REGISTER OF DEEDS

Shirley M. Brown

NOV 8 3 41 PM '93

RECORDED LAKE COUNTY, MI.

Register of Deeds Stamp & File Number

4. Lot No. _____, Recorded Plat _____
5. Private Claims _____

	A	B	C	D	E	F	G	H	I	J	K	L	M
2	6		5		4		3		2		1		
3													
4	7		8		9		10		11		12		
5													
6	18		17		16		15		14		13		
7													
8	19		20		21		22		23		24		
9													
10	30		29		28		27		26		25		
11													
12	31		32		33		34		35		36		
13													

I, Robert L. Wetherell, in a field survey on October 25, 1993, do hereby certify that under requirements of P.A. 74, Michigan P.A. of 1970, the corner points mentioned in lines 1 and 2 above were in conformance with regulations and rules therefore as required in the current manual of survey instructions of the United States Department of the Interior, Bureau of Land Management or by a decree of a Court of Law and/or that the corner points mentioned in lines 3, 4 and 5 above were in conformance with the rules of the Michigan Board of Land Surveyors or by a Decree of a Court of Law; established, re-established, monumented, re-monumented, recovered, found as expressed below:

NOTE: Not more than 4 corners, all in the same town and range, may be recorded on this certificate.

A. Description of original monument and accessories and/or subsequent restoration:

I-13 (Section corner Sections 34 & 35 on the county line, T17N, R14W)

GLO Re-survey 1856 by Thomas Whelpley
 #1 8" Pitch Pine N46-1/2°W 36 Links
 #2 7" Pitch Pine S9-1/2°W 50 Links
 #3 10" Pitch Pine S65°E 57 Links
 #4 8" Nor. Pine N42-1/2°E 23 Links

1917 by Theodore Norlin, Surveyor
 Called for Iron Pipe as Monument
 #5 10" W. Oak N41°W 120.6'
 #6 6" W. Oak N03°E 139.0'

1927 by G.H. Johnson, County Surveyor
 Called for Iron Pipe
 #7 10" W. Oak N42°W 121' (#5)
 #8 8" J. Pine S54°45'E 94.5'

(SEE OVER FOR CONTINUATION OF "A")

B. Description of corner evidence found and/or method applied in restoring or reestablishing corner:

I-13 (Section corner Sections 34 & 35 on the county line, T17N, R14W)

Found 4" dia. x 36" concrete Monument with Brass Cap by G.M. Blass in good condition. Condition of recorded witnesses is: #1 gone; #2 Gone; #3 Gone; #4 Gone; #5 Found in good condition; #6 Gone; #7 Found same as #5; #8 Found nail tree had been cut off; #9 Found in poor condition; #10 Found in good condition; #11 Gone; #12 Same as #5; #13 Gone; #14 Found in good condition; #15 Found spike gone; #16 Did not find.


C. Description of monument for corner and accessories established to perpetuate locating the position of the corner:

I-13 (Section corner Sections 34 & 35 on the county line, T17N, R14W)

Accepted Blass's Concrete Monument with brass cap as a substantial marker for the section corner, and is accepted as a careful and faithful reestablishment of the original corner.

22" W. Oak N41°W 120.60' (#7)
 6" R. Pine S35°W 63.15' (60d. nail in N.W. side of tree) (#15)
 6" J. Pine S20°W 38.00' (60d. nail in N.W. side of tree)
 7" J. Pine S35°E 46.98' (60d. nail in S.W. side of tree)
 Center of Iron in Concrete Plat Monument 33.0' North (#14)

Signed by Robert L. Wetherell Date 11-5-93
Surveyor's Michigan License No. LS 24624

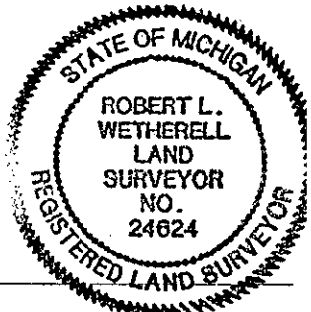

Approved by Peer Review Group October 27, 1993
Robert L. Wetherell, County Representative *R.L.W.*

1965 by G. M. Blass, LS 5489

Found Iron Pipe by Norlin and
set 4" dia. x 36" Concrete Monument

- #9 J. Pine N17°E 30.33'
- #10 10" J. Pine South 34.30'
- #11 12" J. Pine S44°E 94.10' (#8)
- #12 18" W. Oak N41°W 120.60' (#7)
- #13 18" W. Oak N03°E 139.0' (#6)

1968 by R. A. Griffin, LS 13584

Recorded in Liber 01, Page 47

- #14 Center of Iron in Plat Monument
33' North
- #15 3" R. Pine S35°W 63.36'
- #16 Center of Iron in Plat Monument
N.W. 36.91'