

LAND CORNER RECORDATION CERTIFICATE
Filing Requirement of Act 74, Mich. P.A. 1970

LIBER 003 PAGE 0267

For corners in:

<u>Lake</u> (County)	Located In:	Corner Code #
1. Public Land Survey	T 17N R 14W	J-1
	T _____ R _____	_____
	T _____ R _____	_____
	T _____ R _____	_____
2. Property Controlling in Section	S _____ T _____ R _____	_____
	S _____ T _____ R _____	_____
3. Miscellaneous Property in Sec.	S _____ T _____ R _____	_____
	S _____ T _____ R _____	_____
4. Lot No. _____, Recorded Plat _____		
5. Private Claims _____		

STATE OF MICHIGAN) RECORDED 14th DAY OF
 COUNTY OF LAKE) Nov 1994 A.D. at
 O'clock 11:30 A.M.
Sumner K. Nelson REGISTER OF DEEDS

Register of Deeds Stamp & File Number

I, Robert L. Wetherell, in a field survey on October 29, 1994, do hereby certify that under requirements of P.A. 74, Michigan P.A. of 1970, the corner points mentioned in lines 1 and 2 above were in conformance with regulations and rules therefore as required in the current manual of survey instructions of the United States Department of the Interior, Bureau of Land Management or by a decree of a Court of Law and/or that the corner points mentioned in lines 3, 4 and 5 above were in conformance with the rules of the Michigan Board of Land Surveyors or by a Decree of a Court of Law; established, re-established, monumented, re-monumented, recovered, found as expressed below:

	A	B	C	D	E	F	G	H	I	J	K	L	M
2	6	5	4	3	2	1							
3													
4	7	8	9	10	11	12							
5													
6	18	17	16	15	14	13							
7													
8	19	20	21	22	23	24							
9													
10	30	29	28	27	26	25							
11													
12	31	32	33	34	35	36							
13													

NOTE: Not more than 4 corners, all in the same town and range, may be recorded on this certificate.

A. Description of original monument and accessories and/or subsequent restoration:

J-1 - North 1/4 corner of Section 2, T17N, R14W, Lake Township, Lake County, Mi.
NOT SET BY ORIGINAL GOVERNMENT SURVEY 1993 - Robert L. Wetherell, L.S. 24624
 Survey map (Wetherell's File No. 6653-93) of E.1/2-S.E.1/4-N.W.1/4, Sec. 2 shows N.1/4 cor. (1/2" pipe) 1388.43' North of established N.1/16 corner on North and South 1/4 line.

1982 - Robert L. Wetherell, L.S. 24624
 Set 1/2" pipe on the township line and midway between Northwest corner of Section 2 and the Northeast corner of Section 2.

#1 - U.S.F.S. Concrete Monument West 37.60' (S.1/4 corner Sec. 35, T18N, R11W)

B. Description of corner evidence found and/or method applied in restoring or reestablishing corner:

J-1 - North 1/4 corner of Section 2, T17N, R14W, Lake Township, Lake County, Mi.

Found 1/2" pipe in fence intersection East, West and South. Found U.S.F.S. concrete monument 37.60 feet West. Distance to respective section corners is 2676.42 feet.


SATIFIED BY THE LAKE CO. PEER REVIEW GROUP
 IN ACCORDANCE WITH P.A. 345
 CHAIRMAN C. Z. W.
 DATE 11/8/94

C. Description of monument for corner and accessories established to perpetuate locating the position of the corner:

J-1 - North 1/4 corner of Section 2, T17N, R14W, Lake Township, Lake County, Mi.

I replaced the 1/2" pipe with a 3/4" x 24" re-bar with Lake County Brass Cap, and is accepted as a careful and faithful re-establishment of the position of the original corner.

9" B. Oak S11°E 21.63' (60d spike in E. side of tree)
 6" W. Oak S40°W 34.54' (60d spike in S.E. side of tree)
 11" W. Oak N67°E 26.34' (60d spike in N. side of tree)
 5" x 60" U.S.F.S. Concrete Monument - West 37.60' (S.1/4 Cor. of Sec. 35, T18N, R14W)

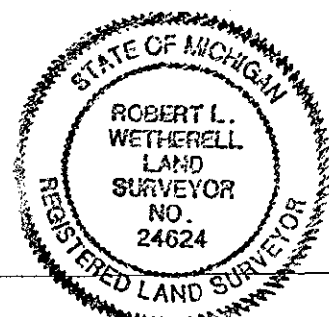

Signed by Robert L. Wetherell Date 11/9/94
 24624

Surveyor's Michigan License No. _____