

NOV 15 1993

LAKE COUNTY REMONUMENTATION LIBER 003 PAGE 0188
COMMISSION LAND CORNER RECORDATION CERTIFICATE
Filing Requirement of Act 74, Mich. P.A. 1970

For corners in LAKE (County)

	Located In:	Corner Code #
1. Public Land Survey	T <u>17N</u> R <u>14W</u>	J-13
	T _____ R _____	_____
	T _____ R _____	_____
	T _____ R _____	_____
2. Property Controlling in Section	S _____ T _____ R _____	_____
	S _____ T _____ R _____	_____
3. Miscellaneous Property in Sec.	S _____ T _____ R _____	_____
	S _____ T _____ R _____	_____
4. Lot No. _____, Recorded Plat _____		
5. Private Claims _____		

RECORDED
LAKE COUNTY, MI.
NOV 8 3 41 PM '93
REGISTER OF DEEDS
Register of Deeds Stamp & File Number

I, Robert L. Wetherell, in a field survey on October 25, 1993, do hereby certify that under requirements of P.A. 74, Michigan P.A. of 1970, the corner points mentioned in lines 1 and 2 above were in conformance with regulations and rules therefore as required in the current manual of survey instructions of the United States Department of the Interior, Bureau of Land Management or by a decree of a Court of Law and/or that the corner points mentioned in lines 3, 4 and 5 above were in conformance with the rules of the Michigan Board of Land Surveyors or by a Decree of a Court of Law; established, re-established, monumented, re-monumented, recovered, found as expressed below:

NOTE: Not more than 4 corners, all in the same town and range, may be recorded on this certificate.

	A	B	C	D	E	F	G	H	I	J	K	L	M
2	6	5	4	3	2	1							
3													
4	7	8	9	10	11	12							
5													
6	18	17	16	15	14	13							
7													
8	19	20	21	22	23	24							
9													
10	30	29	28	27	26	25							
11													
12	31	32	33	34	35	36							
13													

A. Description of original monument and accessories and/or subsequent restoration:

J-13 (1/4 Corner Section 35 on the county line, T17N, R14W)

GLO Re-survey 1856 by Thomas Whelpley
#1 8" Pitch Pine S3-1/2°E 37 Links
#2 10 Pitch Pine N55°E 45 Links

1917 by Theodore Norlin, Surveyor
Called for Iron Pipe as Monument
#3 12" B. Oak S52°E 84.0'
#4 10" Pine N76°E 79.2'

1927 by G.H. Johnson, Lake County Surveyor
Called for Iron Pipe
#5 12" B. Oak S48°30'E 84.0' (#3)
#6 10" B. Oak N10°30'E 14.8'

(SEE OVER FOR CONTINUATION OF "A")

B. Description of corner evidence found and/or method applied in restoring or reestablishing corner:

J-13 (1/4 Corner Section 35 on the county line, T17N, R14W)


Found 5" Sq. x 36" Concrete Monument with Brass Cap 1' below road surface, set by R.A. Griffin. Condition of recorded witnesses is: #1 gone; #2 Gone; #3 Found in good condition; #4 Gone; #5 Same as #3; #6 Gone; #7 Tree down, found stump; #8 Found in good condition; #9 Found in good condition; #10 Gone; #11 Found in good condition; #12 Found in good condition; #13 Found in good condition.

C. Description of monument for corner and accessories established to perpetuate locating the position of the corner:

J-13 (1/4 Corner Section 35 on the county line, T17N, R14W)

Accepted Griffin's Concrete Monument with brass cap as a substantial marker for the 1/4 corner, and is accepted as a careful and faithful reestablishment of the position of the original corner.

- 10" B. Oak S67°E 38.95' (60d. nail in N.E. side of tree) (#8)
- 8" W. Oak S39°W 73.87' (60d. nail in N.W. side of tree) (#9)
- 10" B. Oak S67°E 97.49' (10" dock spike in S.W. side of tree) (#11)
- 8" W. Oak N54°W 92.13' (10" dock spike in N.E. side of tree) (#12)
- 4" x 7' Pine Post 32.97' East (#13)

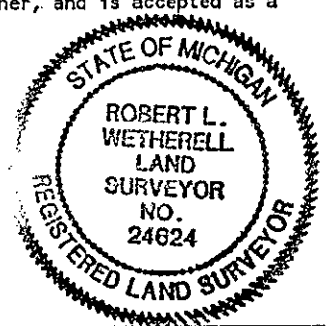

Signed by Robert L. Wetherell Date 11-5-93
Surveyor's Michigan License No. LS 24624

Approved by Peer Review Group October 27, 1993
Robert L. Wetherell, County Representative R.L.W.

1965 by G.M. Blass, LS 5489

Called for Pipe

#7 12" B. Oak N35°E 45.80'

#8 10" B. Oak S66°E 38.65'

#9 8" W. Oak S42°W 73.60'

1968 by R.A. Griffin, LS 13584

Griffin found 3/4" x 18" Pipe

replaced with 5" Concrete Monument

Recorded in Liber 01, Page 50.

#11 7" B. Oak S67°E 97.49'

#12 5" W. Oak N54°W 92.13'

#13 4" Sq. x 7' Pine Post 32.97' East