

JAN 12 1996

COMMISSION

LAND CORNER RECORDATION CERTIFICATE
Filing Requirement of Act 74, Mich. P.A. 1970

LIBER 003 PAGE 0325

For corners in

Lake (County)	Located In:		Corner Code #
	17N	14W	
1. Public Land Survey	T _____	R _____	K-8
	T _____	R _____	
	T _____	R _____	
	T _____	R _____	
2. Property Controlling in Section	S _____	T _____	R _____
	S _____	T _____	R _____
3. Miscellaneous Property in Sec.	S _____	T _____	R _____
	S _____	T _____	R _____

RECORDED
LAKE COUNTY, MI.
SEP 5 3 06 PM '95
REGISTER OF DEEDS
Deborah M. Adams

Register of Deeds Stamp & File Number

4. Lot No. _____, Recorded Plat _____
5. Private Claims _____

Robert L. Wetherell August 16, 1995

I hereby certify that under requirements of P.A. 74, Michigan P.A. of 1970, the corner points mentioned in lines 1 and 2 above were in conformance with regulations and rules therefore as required in the current manual of survey instructions of the United States Department of the Interior, Bureau of Land Management or by a decree of a Court of Law and/or that the corner points mentioned in lines 3, 4 and 5 above were in conformance with the rules of the Michigan Board of Land Surveyors or by a Decree of a Court of Law; established, re-established, monumented, re-monumented, recovered, found as expressed below:

	A	B	C	D	E	F	G	H	I	J	K	L	M
2	6	5	4	3	2	1							
3													
4	7	8	9	10	11	12							
5													
6	18	17	16	15	14	13							
7													
8	19	20	21	22	23	24							
9													
10	30	29	28	27	26	25							
11													
12	31	32	33	34	35	36							
13													

NOTE: Not more than 4 corners, all in the same town and range, may be recorded on this certificate.

A. Description of original monument and accessories and/or subsequent restoration:
K-8 - 1/4 Corner common to Sections 23 & 24, T17N, R14W, Lake Twp., Lake Co., Mi.

- | | | |
|------------------------------|-------------------------------------|---------------------------------|
| 1838 - John Hodgson, G.L.O. | 1918 - George Johnson, Co. Surveyor | Undated - County Survey Records |
| #1 - 12" Pine S52°W 24 Links | #3 - 10" B. Oak N7°E 53' | #4 - 12" B. Oak N39°W 46' |
| #2 - 6" Pine N40°E 11 Links | | #5 - 10" W. Oak N38°E 60.5' |
| | | #6 - 10" B. Oak N6°E 38' |

(SEE OVER FOR CONTINUATION OF "A")

B. Description of corner evidence found and/or method applied in restoring or reestablishing corner:

K-8 - 1/4 Corner common to Sections 23 & 24, T17N, R14W, Lake Twp., Lake Co., Mi.


I found Griffin's 5" Concrete Monument 5 feet more or Less South of centerline of East and West Blacktop road 13 inches below surface in monument box. Condition of accessories are as follows: #1 Gone, #2 Gone, #3 Gone, #4 Gone, #5 Gone, #6 Gone, #7 Gone, #8 Found in good condition, #9 Found in good condition, #10 Gone, #11 Gone #12 Found in good condition, #13 Found in good condition, #14 Found in good condition.

C. Description of monument for corner and accessories established to perpetuate locating the position of the corner:

K-8 - 1/4 Corner common to Sections 23 & 24, T17N, R14W, Lake Twp., Lake Co., Mi.

I placed a 3/4" re-bar with Lake County Brass Cap directly over the 5" Square Concrete Monument and is accepted as a careful and faithful re-establishment of the position of the original corner.

- 17" W. Oak N47°E 70.07' (60d spike in N.W. side) #8
- 7" B. Oak N4°W 87.70' (60d spike in E. side)
- 15" Triple B. Oak S36°W 43.83' (60d spike in S.E. side) #9
- 9" W. Oak S30°E 55.25' (Dock spike in E. side) #12

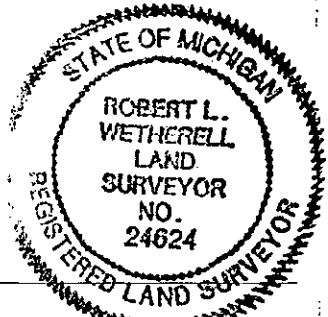

Signed by Robert L. Wetherell Date August 29, 1995
24624

Surveyor's Michigan License No. _____
CERTIFIED BY THE LAKE CO. PEER REVIEW GROUP
IN ACCORDANCE WITH P.A. 345
CHAIRMAN R. L. W.
DATE _____

SURVEY &
REMONUMENTATION

JAN 1 2 1996
COMMISSION

CONTINUATION OF "A" - DESCRIPTION OF ORIGINAL MONUMENT AND ACCESSORIES AND/OR SUBSEQUENT RESTORATION:

1955 - George Blass, L.S. 5489

Found 1" Iron Rod

7 - P. Pole N30°E 41.37'

8 - 12" W. Oak N44°E 69.70' (O.B.T.)

9 - 8" B. Oak S35°W 43.60' (O.B.T.)

#10 - 14" B. Oak N25°W 42.80' (O.B.T.)

Corner is 5.5' South of centerline

1970 - Robert Griffin, LS 13584

Found 1" x 18" Iron Rod and replaced with a
5" Square Concrete Monument.

#11 - 4" x 7' Wood Post North 33.0'

#12 - 6" Tw. W. Oak S27°E 55.25'

#13 - 8" B. Oak S15°W 37.75'

#14 - C. W. 1/16 corner Sec. 24,
S89°35'10"E 1316.65'