

SURVEY & REMONUMENTATION

NOV 15 1993

COMMISSION

LAKE COUNTY REMONUMENTATION

LAND CORNER RECORDATION CERTIFICATE
Filing Requirement of Act 74, Mich. P.A. 1970

LIBER 003 PAGE 0190

For corners in
LAKE

(County)	Located In:	Corner Code #
1. Public Land Survey	T 17N R 14W	K-13
	T _____ R _____	_____
	T _____ R _____	_____
	T _____ R _____	_____
2. Property Controlling in Section	S _____ T _____ R _____	_____
	S _____ T _____ R _____	_____
3. Miscellaneous Property in Sec.	S _____ T _____ R _____	_____
	S _____ T _____ R _____	_____
4. Lot No. _____, Recorded Plat _____		
5. Private Claims _____		

REGISTER OF DEEDS
 Nov 8 3 41 PM '93
 RECORDED
 LAKE COUNTY, MI.

Register of Deeds Stamp & File Number

	A	B	C	D	E	F	G	H	I	J	K	L	M
2	6	5	4	3	2	1							
3													
4	7	8	9	10	11	12							
5													
6	18	17	16	15	14	13							
7													
8	19	20	21	22	23	24							
9													
10	30	29	28	27	26	25							
11													
12	31	32	33	34	35	36							
13													

I, Robert L. Wetherell, in a field survey on October 25, 19 93, do hereby certify that under requirements of P.A. 74, Michigan P.A. of 1970, the corner points mentioned in lines 1 and 2 above were in conformance with regulations and rules therefore as required in the current manual of survey instructions of the United States Department of the Interior, Bureau of Land Management or by a decree of a Court of Law and/or that the corner points mentioned in lines 3, 4 and 5 above were in conformance with the rules of the Michigan Board of Land Surveyors or by a Decree of a Court of Law; established, re-established, monumented, re-monumented, recovered, found as expressed below:

NOTE: Not more than 4 corners, all in the same town and range, may be recorded on this certificate.

A. Description of original monument and accessories and/or subsequent restoration:

K-13 (Section corner Sections 35 & 36 on the county line, T17N, R14W)
1856 by Thomas Whelpley 1927 G.H. Johnson, County Surveyor
 #1 8" Pitch Pine S82°W 27 Links Called for Iron Pipe
 #2 9" Pitch Pine S52°E 61 Links #5 7" B. Oak N56°30'W 37.0'
1917 by Theodore Norlin, Surveyor #6 9" B. Oak S57°15'E 44.0'
Called for Iron Pipe as Monument
 #3 8" B. Oak S34°E 53.0'
 #4 6" W. Oak N35°W 96.0'


1973 by R.A. Griffin, LS 13584
 Found 5" Sq. x 60"
 Concrete Monument
 Recorded in Liber 2, Page 191
 # 7 8" W. Oak N43°E 86.10'
 # 8 4" R. Oak S29°E 32.26'
 # 9 3" Tw. Maple S40°W 60.11'
 #10 4" R. Oak N66°W 59.68'
 #11 4" Sq. x 7' Pine Post
 1.4' West

B. Description of corner evidence found and/or method applied in restoring or reestablishing corner:

K-13 (Section corner Sections 35 & 36 on the county line, T17N, R14W)
 On August 13, 1968, R.A. Griffin found 1" x 18" Pipe and accessories. #3 (stump), #4 (stump) and #5. He replaced pipe with a 5" Sq. x 60" Concrete monument with brass cap in 1973.
 I found 5" Sq. x 60" Concrete Monument with brass cap by R.A. Griffin.
 Condition of witnesses is: #1 Gone; #2 Gone; #3 Gone; #4 Gone; #5 Gone; #6 Gone; #7 Found in good condition; #8 Found in good condition; #9 Found in good condition; #10 Found tree dead; #11 Found in good condition.

C. Description of monument for corner and accessories established to perpetuate locating the position of the corner:

K-13 (Section corner Sections 35 & 36 on the county line, T17N, R14W)
 Accepted Griffin's concrete monument with brass cap as a substantial marker for the Section corner and is accepted as a careful and faithful reestablishment of the position of the original corner.
 60d. Spike or 10 Dock Spike in the following trees
 8" W. Oak N43°E 86.10' (#7)
 4" R. Oak S29°E 32.26' (#8)
 3" Tw. Maple S40°W 60.11' (#9)
 10" W. Oak N78°W 73.40'
 4" Sq. x 7' Pine Post 1.4' West (#11)

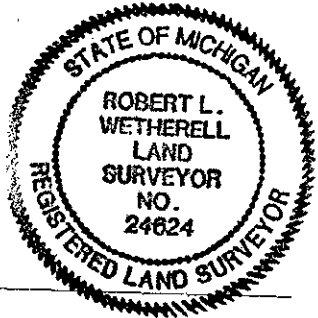

Signed by Robert L. Wetherell Date 11-5-93
 Surveyor's Michigan License No. LS 24624

Approved by Peer Review Group October 27, 1993
 Robert L. Wetherell, County Representative R.L.W.