

SURVEY & REMONUMENTATION

NOV 15 1993

COMMISSION

LAKE COUNTY REMONUMENTATION

LAND CORNER RECORDATION CERTIFICATE

Filing Requirement of Act 74, Mich. P.A. 1970

LIBER 003 PAGE 0191

For corners in LAKE

(County)	Located In:	Corner Code -#
1. Public Land Survey	T 17N R 14W	L-13
	T _____ R _____	_____
	T _____ R _____	_____
	T _____ R _____	_____
2. Property Controlling in Section	S _____ T _____ R _____	_____
	S _____ T _____ R _____	_____
3. Miscellaneous Property in Sec.	S _____ T _____ R _____	_____
	S _____ T _____ R _____	_____

REGISTERED
 LAKE COUNTY, MI.
 NOV 8 3 41 PM '93
 REGISTER OF DEEDS

Register of Deeds Stamp & File Number

4. Lot No. _____, Recorded Plat _____
 5. Private Claims _____

	A	B	C	D	E	F	G	H	I	J	K	L	M
2	6	5	4	3	2	1							
3													
4	7	8	9	10	11	12							
5													
6	18	17	16	15	14	13							
7													
8	19	20	21	22	23	24							
9													
10	30	29	28	27	26	25							
11													
12	31	32	33	34	35	36							
13													

I, Robert L. Wetherell, in a field survey on October 25, 19 93, do hereby certify that under requirements of P.A. 74, Michigan P.A. of 1970, the corner points mentioned in lines 1 and 2 above were in conformance with regulations and rules therefore as required in the current manual of survey instructions of the United States Department of the Interior, Bureau of Land Management or by a decree of a Court of Law and/or that the corner points mentioned in lines 3, 4 and 5 above were in conformance with the rules of the Michigan Board of Land Surveyors or by a Decree of a Court of Law; established, re-established, monumented, re-monumented, recovered, found as expressed below:

NOTE: Not more than 4 corners, all in the same town and range, may be recorded on this certificate.

A. Description of original monument and accessories and/or subsequent restoration:

L-13 (1/4 Corner Section 36 on the county line, T17N, R14W)

1856 by Thomas Whelpley
 5" Aspen N39°E 10 Links
 6" B. Oak N50°W 19 Links

Undated Survey by G.H. Johnson, Lake County Surveyor
 7" Tw. B. Oak N56°W 37.0'
 6" B. Oak N57°E 44.0'

B. Description of corner evidence found and/or method applied in restoring or reestablishing corner:

L-13 (1/4 Corner Section 36 on the county line, T17N, R14W)

Found no remains of previous surveys. This corner was established by single proportional measurement, considered as a lost corner, and on a straight line between controlling corners.

2641.16 feet to the S.E. corner Section 36
 2641.16 feet to the S.W. corner Section 36

C. Description of monument for corner and accessories established to perpetuate locating the position of the corner:


L-13 (1/4 Corner Section 36 on the county line, T17N, R14W)

Set 3/4" x 24" Re-rod with brass cap (Lake County Remonumentation Marker) and is accepted as a careful and faithful reestablishment of the position of the original corner.

60d. Spike was placed in the following trees:
 16" W. Oak S46°E 51.65' (nail in S.W. side of tree)
 14" W. Oak N21°E 37.14' (nail in N.W. side of tree)
 9" W. Oak N34°W 34.22' (nail in N.E. side of tree)
 9" R. Pine S34°W 18.01' (nail in N.W. side of tree)
 C/L two track road 18' North

Signed by Robert L. Wetherell Date 11-5-93

Surveyor's Michigan License No. LS 24624

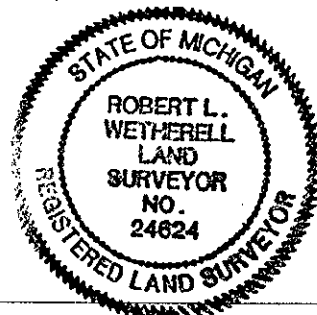

Approved by Peer Review Group October 27, 1993
 Robert L. Wetherell, County Representative RLW.