

SURVEY & REMONUMENTATION

NOV 15 1993

COMMISSION

LAKE COUNTY REMONUMENTATION

LAND CORNER RECORDATION CERTIFICATE
Filing Requirement of Act 74, Mich. P.A. 1970

LIBER 003 PAGE 0192

RECORDED
 LAKE COUNTY, MI.
 NOV 03 41 PM '93
 REGISTER OF DEEDS

For corners in LAKE (County) Located In: Corner Code =#

1. Public Land Survey	T 17N R 14W	M-13
	T R	
	T R	
	T R	
2. Property Controlling in Section	S T R	
	S T R	
3. Miscellaneous Property in Sec.	S T R	
	S T R	

Register of Deeds Stamp & File Number

- 4. Lot No. _____, Recorded Plat _____
- 5. Private Claims _____

A	B	C	D	E	F	G	H	I	J	K	L	M
2	6	5	4	3	2	1						
3												
4	7	8	9	10	11	12						
5												
6	18	17	16	15	14	13						
7												
8	19	20	21	22	23	24						
9												
10	30	29	28	27	26	25						
11												
12	31	32	33	34	35	36						
13												

I, Robert L. Wetherell, in a field survey on October 19, 19 93, do hereby certify that under requirements of P.A. 74, Michigan P.A. of 1970, the corner points mentioned in lines 1 and 2 above were in conformance with regulations and rules therefore as required in the current manual of survey instructions of the United States Department of the Interior, Bureau of Land Management or by a decree of a Court of Law and/or that the corner points mentioned in lines 3, 4 and 5 above were in conformance with the rules of the Michigan Board of Land Surveyors or by a Decree of a Court of Law; established, re-established, monumented, re-monumented, recovered, found as expressed below:

NOTE: Not more than 4 corners, all in the same town and range, may be recorded on this certificate.

A. Description of original monument and accessories and/or subsequent restoration:
 M-13 (Section corner Sections 36-31-1-6, T17N, R14W, S.E. corner Section 36)

1938 GLO by Mullett
 #1 14" Maple S71°E 34 Links
 #2 10" Maple N81°W 27 Links

Undated Survey (1920's) by G.H. Johnson, Lake County Surveyor
 Monument 4" x 4" Oak Post
 #3 Pine Stump South 33'
 #4 Pine Stump N. of E. 21'
 #5 W. Oak W. on line 76'

1980 by R.A. Griffin, LS 13584
 Griffin found post by Johnson replaced with 1-1/2" x 60" Iron Pipe with Brass Cap
 # 6 14" W. Oak N53°W 36.00' (OBT)
 # 7 18" W. Oak S76°W 75.75' (OBT)
 # 8 6" R. Maple S86°E 48.98'
 # 9 5" R. Maple S08°E 17.43'
 #10 4" Pine Post 1.94' North

B. Description of corner evidence found and/or method applied in restoring or reestablishing corner:

M-13 (Section corner Sections 36-31-1-6, T17N, R14W, S.E. corner Section 36)

Found 1 1/2" x 60" Iron Pipe with brass cap by R.A. Griffin.


Condition of recorded witnesses is: #1 Gone; #2 Gone; #3 Found stump in poor condition; #4 Found stump in poor condition; #5 Found W. Oak has been blown down; #6 Found in good condition; #7 Found W. Oak has been blown down; #8 Found in good condition; #9 Found in good condition; #10 Found in good condition.

C. Description of monument for corner and accessories established to perpetuate locating the position of the corner:

M-13 (Section corner Sections 36-31-1-6, T17N, R14W, S.E. corner Section 36)

Accepted Griffins Iron Pipe with brass cap as a substantial marker for the Section Corner and is accepted as a careful and faithful reestablishment of the position of the original corner.

- 60d. Spike or 10" Dock Spike in the following trees
- 4" Pine Post North 1.94' (#10)
- 14" W. Oak N53°W 36.00' (#6)
- 6" R. Maple S88°E 48.98' (#8)
- 5" R. Maple S08°E 17.43' (#9)
- 11" W. Oak S71°W 63.70' (nail in S.E. side of tree)

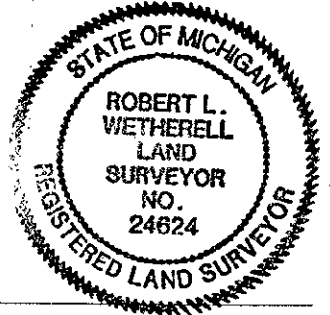

Signed by Robert L. Wetherell Date 11-5-93
 Surveyor's Michigan License No. LS 24624

Approved by Peer Review Group October 27, 1993
 Robert L. Wetherell, County Representative R.L.W.