

Lake Co.

# LAND CORNER RECORDATION CERTIFICATE

## FILING REQUIREMENT OF ACT 74, MICH. P.A.1970

| FOR CORNERS OF--                      | LOCATED IN--         | CORNER CODE NUMBER |
|---------------------------------------|----------------------|--------------------|
| 1. PUBLIC LAND SURVEY                 | T. 18 N. R. 11 W.    | H-11; I-11:        |
| 2. PROPERTY CONTROLLING IN SECTION    | 27 T. 18 N. R. 11 W. | Code 16            |
| 3. MISCELLANEOUS PROPERTY IN SECTION  | T. S. R. E. W.       |                    |
| 4. LOT NO. _____, RECORDED PLAT _____ |                      |                    |
| 5. PRIVATE CLAIMS _____               |                      |                    |

REGISTER OF DEEDS STAMP AND FILING NUMBER

I, Carl F. Roser do hereby certify that under requirements of P.A. 74, Michigan P.A. of 1970, the corner points mentioned in lines 1 and 2 above (identified with circles on index code diagram - over) were, in a field survey on 6-27 1973, established, re-established, monumented, re-monumented, recovered or restored as expressed below and in conformance with regulations and rules therefore as required in the current manual of survey instructions of the United States Department of the Interior, Bureau of Land Management or by a decree of a court of law. Furthermore, that the corner points mentioned in lines 3, 4 and 5 above were, in a field survey on \_\_\_\_\_ 19\_\_\_\_, found, recovered, restored, established or re-established as expressed below and in conformance with the rules of the Michigan State Board of Registration for Land Surveyors or, by a Decree of a Court of law:

A. Description of original monument and accessories and/or subsequent restoration:

B. Description of corner evidence found and/or method applied in restoring or re-establishing corner:

- H-11 Restored corner in Center of E-W gravel road, on split of R.O.W. fences and in line with fences to N & S.
- I-11 Recovered pointed stone, buried, from two G. Johnson wit. of record. Corner fits 1/8 line and 1/4 line fences to West. Corner is on approx. center of E-W gravel rd and 6'± E of approx. center gr road to S.
- 16 Established corner per standard B.L.M. instructions.

C. Description of monument for corner and accessories established to perpetuate locating the position of the corner:

| H-11                              | I-11   | Code 16                                    |
|-----------------------------------|--|--|
| Set DNR Mon. 12" Ash N33W 39.9    | Fd. stone, added Std. DNR Mon. 18" R. Oak N24W 58.7' | Set 1"x36" pipe in N Edge of E-W Sand Road |
| 6" Maple N33E 38.0                | 5" R. Oak N30E 20.9'                                 | Set Ced Post w/loc tag                     |
| Set Ced. post w/loc tag Due N 25' | 17" Maple S40W 50.0'                                 | Due N 20'                                  |
| Cor. Fn Post (Fn E-W-N) Due N 31' | Set Ced post w/loc tag Due N 33'                     | 7" Maple N73 E 37.8'                       |
| Cor. Fn Post (Fn E-W-S) Due S 31' |  | 18" Beech S32 E 43.8'                      |
|                                   |  | E-W R.O.W. Fn. Due S 35'                   |
|                                   |  | Cor. Fn. Post (Fn W & N), 24'              |


SIGNED BY Carl F. Roser DATE 9-24-73

SURVEYOR'S MICHIGAN REGISTRATION NO. 12028

FOR STATE AND UNITED STATES AGENCIES:

SIGNED BY \_\_\_\_\_ DATE \_\_\_\_\_

APPROVED AND SIGNED BY \_\_\_\_\_ MICHIGAN REGISTERED LAND SURVEYOR

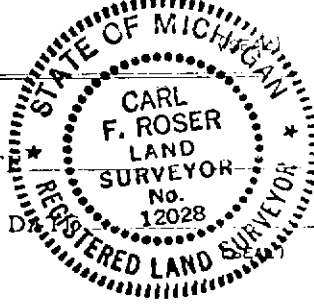

SURVEYOR'S MICHIGAN REGISTRATION NO. \_\_\_\_\_