

# LAND CORNER RECORDATION CERTIFICATE

## FILING REQUIREMENT OF ACT 74, MICH. P.A.1970

FOR CORNERS OF--:	LOCATED IN--:	CORNER CODE NUMBER
1. PUBLIC LAND SURVEY _____	T. <u>18</u> <sup>N.</sup> <sub>•</sub> , R. <u>11</u> <sup>•</sup> <sub>W.</sub>	<u>F-9; G-9; G-10; G-11</u>
2. PROPERTY CONTROLLING IN SECTION _____	T. _____, S. _____, R. _____, E. _____, W. _____	_____
3. MISCELLANEOUS PROPERTY IN SECTION _____	T. _____, S. _____, R. _____, E. _____, W. _____	_____
4. LOT NO. _____, RECORDED PLAT _____		
5. PRIVATE CLAIMS _____		

REGISTER OF DEEDS STAMP AND FILING NUMBER

I, Carl F. Roser do hereby certify that under requirements of P.A. 74, Michigan P.A. of 1970, the corner points mentioned in lines 1 and 2 above (identified with circles on index code diagram - over) were, in a field survey on 5-14 1973, established, re-established, monumented, re-monumented, recovered or restored as expressed below and in conformance with regulations and rules therefore as required in the current manual of survey instructions of the United States Department of the Interior, Bureau of Land Management or by a decree of a court of law. Furthermore, that the corner points mentioned in lines 3, 4 and 5 above were, in a field survey on \_\_\_\_\_ 19\_\_\_\_, found, recovered, restored, established or re-established as expressed below and in conformance with the rules of the Michigan State Board of Registration for Land Surveyors or, by a Decree of a Court of law:

~~A. Description of original monumentation as shown on index code diagram~~

C. continued G-11  
 Fd. pipe, added DNR monument  
 6" R. Pine N43E 65.15  
 30" Maple S12E 100.92  
 cor. fence post S40W 45.58  
 w/loc tag.

B. Description of corner evidence found and/or method applied in restoring or re-establishing corner:

- F-9 Found G. Blass monument of record.
- G-9 Found G. Blass monument of record.
- G-10 Found G. Blass monument of record.
- G-11 Found G. Blass monument of record.

C. Description of monument for corner and accessories established to perpetuate locating the position of the corner:

F-9	G-9	G-10
Fd. conc. mon w/rein rod, added Ced post & tag	Fd Conc. mon w/rein rod added Ced. post & tag	Fd. conc. mon w/Rein rod
12" W. Oak S23W 37.7	15" R. Oak N40W 25.3	Fn. cor S88E 33.76
6" W.Oak trplN46E 34.9	26" R. Oak N25E 17.2	26" Beech S73W 35.40
5" W. Oak N82W 35.8	13" Tw Maple S55E 22.4	18" Tw Maple N55W 41.67
5" W. Oak S53E 5.7	12" Tw W.Oak S12W 83.0 (spike in W side)	Set Loc tag on cor fence post Due E 33'
		Conc. mon. S87W 33'


SIGNED BY Carl F. Roser DATE 9-24-13

SURVEYOR'S MICHIGAN REGISTRATION NO. 12028

FOR STATE AND UNITED STATES AGENCIES:

SIGNED BY \_\_\_\_\_ DATE \_\_\_\_\_

APPROVED AND SIGNED BY \_\_\_\_\_ DATE \_\_\_\_\_

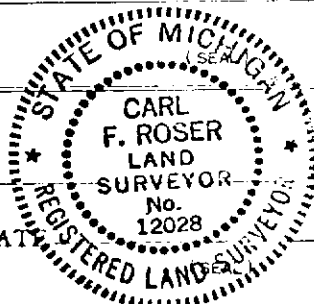

SURVEYOR'S MICHIGAN REGISTRATION NO. \_\_\_\_\_