

# LAND CORNER RECORDATION CERTIFICATE

## FILING REQUIREMENT OF ACT 74, MICH. P.A.1970

FOR CORNERS OF--:	LOCATED IN--:	CORNER CODE NUMBER
1. PUBLIC LAND SURVEY _____	T. <u>18</u> N. <u>●</u> , R. <u>11</u> W. <u>●</u>	D-3; D-5; E-3; E-5
2. PROPERTY CONTROLLING IN SECTION _____	T. _____ N. _____ S., R. _____ E. _____ W. _____	_____
3. MISCELLANEOUS PROPERTY IN SECTION _____	T. _____ N. _____ S., R. _____ E. _____ W. _____	_____
4. LOT NO. _____, RECORDED PLAT _____		
5. PRIVATE CLAIMS _____		

REGISTER OF DEEDS STAMP AND FILING NUMBER

I, Carl F. Roser do hereby certify that under requirements of P.A. 74, Michigan P.A. of 1970, the corner points mentioned in lines 1 and 2 above (identified with circles on index code diagram—over) were, in a field survey on 6-6 1973, established, re-established, monumented, re-monumented, recovered or restored as expressed below and in conformance with regulations and rules therefore as required in the current manual of survey instructions of the United States Department of the Interior, Bureau of Land Management or by a decree of a court of law. Furthermore, that the corner points mentioned in lines 3, 4 and 5 above were, in a field survey on \_\_\_\_\_ 19\_\_\_\_, found, recovered, restored, established or re-established as expressed below and in conformance with the rules of the Michigan State Board of Registration for Land Surveyors or, by a Decree of a Court of law:

~~A. Description of monument for corner and accessories established to perpetuate locating the position of the corner:~~

C. cont. E-5

Fd. pipe, added DNR mon & ced. post	
7" trpl Maple	N44W 24.4
18" W. Oak	N84E 46.1
5" Maple 6-clump	S52E 15.3
18" B. Oak	S80W 48.5

B. Description of corner evidence found and/or method applied in restoring or re-establishing corner:

- D-3 Found iron and two F. Jones NBTs. Old corner of record.
- D-5 Found iron and one F. Jones NBT in center of N-S road. Old corner of record.
- E-3 Found iron & two F. Jones NBTs. Old corner of record.
- E-5 Found pipe and two G. Johnson NBTs. Old corner of record.

C. Description of monument for corner and accessories established to perpetuate locating the position of the corner:

D-3	D-5	E-3
Fd iron, added DNR mon. buried.	Fd 2' fence post iron, added DNR monument	Fd. iron, added DNR Mon.
10" B. Oak S40W 40.5'	10" W. Oak S44W 55.2	18" W. Oak S46W 52.03
11" Maple N70W 26.1'	8" Maple 5-cl.N32W 51.3	23" B. Oak 2-clmp N65W 137.41
7" Maple N50E 36.5'	12" W. Oak N71E 57.6	12" W.Oak S47E 62.10
Set Ced post w/loc tag Due E 33'	Set Ced.Post w/loc tag Due E 33'	Set Ced post w/loc tag Due N 33'
		Ctr E-W sand & gravel road Due N 2'


SIGNED BY Carl F. Roser DATE 9-24-73

SURVEYOR'S MICHIGAN REGISTRATION NO. 12028

FOR STATE AND UNITED STATES AGENCIES:

SIGNED BY \_\_\_\_\_ DATE \_\_\_\_\_  
CHIEF OF SURVEY PARTY

APPROVED AND SIGNED BY \_\_\_\_\_ DATE \_\_\_\_\_  
MICHIGAN REGISTERED LAND SURVEYOR

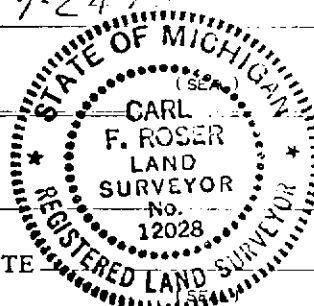

SURVEYOR'S MICHIGAN REGISTRATION NO. \_\_\_\_\_