

LAND CORNER RECORDATION CERTIFICATE

FILING REQUIREMENT OF ACT 74, MICH. P.A. 1970

FOR CORNERS OF--	LOCATED IN--	CORNER CODE NUMBER
1. PUBLIC LAND SURVEY _____	T. <u>18</u> N. R. <u>11</u> W.	<u>F-5; G-5; G-6</u>
2. PROPERTY CONTROLLING IN SECTION _____	T. _____ N. S. R. _____ E. W.	_____
3. MISCELLANEOUS PROPERTY IN SECTION _____	T. _____ N. S. R. _____ E. W.	_____
4. LOT NO. _____, RECORDED PLAT _____		
5. PRIVATE CLAIMS _____		

REGISTER OF DEEDS STAMP AND FILING NUMBER

I, Carl F. Roser do hereby certify that under requirements of P.A. 74, Michigan P.A. of 1970, the corner points mentioned in lines 1 and 2 above (identified with circles on index code diagram - over) were, in a field survey on July 10 1973, established, re-established, monumented, re-monumented, recovered or restored as expressed below and in conformance with regulations and rules therefore as required in the current manual of survey instructions of the United States Department of the Interior, Bureau of Land Management or by a decree of a court of law. Furthermore, that the corner points mentioned in lines 3, 4 and 5 above were, in a field survey on _____ 19____, found, recovered, restored, established or re-established as expressed below and in conformance with the rules of the Michigan State Board of Registration for Land Surveyors or, by a Decree of a Court of law:

A. Description of original monument and accessories and/or subsequent restoration:

B. Description of corner evidence found and/or method applied in restoring or re-establishing corner:

- F-5 Reestablish corner per standard B.L.M. instructions.
- G-5 Restored corner by proportionate distance to U.S. for one mile S, 1/2 mile N and approximate proportion to U.S. for one mile E & W which places corner 39' south of vague burnt corner fn. post (vague burnt fn. remains 800'± W & 1/4 mile N).
- G-6 Reestablish corner per standard B.L.M. instructions.

C. Description of monument for corner and accessories established to perpetuate locating the position of the corner:

F-5	G-5	G-6
Set DNR Mon. & Ced. Gd. Post	Set CNR Mon. & Ced. Gd. Post	Set DNR Mon. & Ced. Gd. Post
14" W. Oak N17°W 9.4'	19" R. Pine N82°W 44.2'	15" R. Oak N45°W 16.6'
9" R. Oak S52°E 6.0'	2" W. Pine N20°E 14.6'	6" R. Oak N31°E 23.1'
5" W. Oak N63°W 4.5'	8" W. Pine S29°E 28.8'	9" R. Oak S10°E 10.2'


SIGNED BY Carl F. Roser DATE 9-24-73

SURVEYOR'S MICHIGAN REGISTRATION NO. 12028

FOR STATE AND UNITED STATES AGENCIES:

SIGNED BY _____ DATE _____
CHIEF OF SURVEY PARTY

APPROVED AND SIGNED BY _____
MICHIGAN REGISTERED LAND SURVEYOR

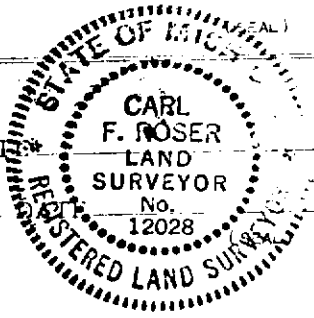

SURVEYOR'S MICHIGAN REGISTRATION NO. _____