

SURVEY & REMONUMENTATION

JAN 25 2001 LAND CORNER RECORDATION CERTIFICATE

FILING REQUIREMENT OF ACT 74, Mich. P.A. 1970

SECTION

RECORDED
LAKE COUNTY, MI.
LIBER004 PAGE0232

| | | |
|---------------------------------------|---------------|--------------|
| For corners in Lake _____ | Located in: | Corner Code# |
| 1. Public Land Survey | T 18 N R 11 W | C-7 |
| | T R | |
| | T R | |
| | T R | |
| 2. Property Controlling in Section | S T R | |
| | S T R | |
| 3. Miscellaneous Property in Sec. | S T R | |
| | S T R | |
| 4. Lot No. _____ Recorded Plat _____ | | |
| 5. Private Claims _____ | | |

MAY 5 10 24 AM '00

Shelley Myers

REGISTER OF DEEDS

Register of Deeds Stamp & File Number

I, Robert L. Wetherell, in a field survey on March 16, 2000, do hereby certify that under requirements of P.A. 74, Michigan P.A. of 1970, the corner points mentioned in lines 1 and 2 above were in conformance with regulations and rules therefore as required in the current manual of survey instructions of the United States Department of the Interior, Bureau of Land Management or by decree of a Court of Law and/or that the corner points mentioned in lines 3, 4, and 5 above were in conformance with the rules of the Michigan Board of Land Surveyors or by a Decree of a Court of Law, established, re-established, monumented, re-monumented, recovered, found as expressed below:

C-7 - Section corner common to Sections 17, 18, 19 & 20, T18N, R11W

| | A | B | C | D | E | F | G | H | I | J | K | L | M |
|----|----|----|----|----|----|----|---|---|---|---|---|---|---|
| 1 | | | | | | | | | | | | | |
| 2 | 6 | 5 | 4 | 3 | 2 | 1 | | | | | | | |
| 3 | | | | | | | | | | | | | |
| 4 | 7 | 8 | 9 | 10 | 11 | 12 | | | | | | | |
| 5 | | | | | | | | | | | | | |
| 6 | 18 | 17 | 16 | 15 | 14 | 13 | | | | | | | |
| 7 | | | | | | | | | | | | | |
| 8 | 19 | 20 | 21 | 22 | 23 | 24 | | | | | | | |
| 9 | | | | | | | | | | | | | |
| 10 | 30 | 29 | 28 | 27 | 26 | 25 | | | | | | | |
| 11 | | | | | | | | | | | | | |
| 12 | 31 | 32 | 33 | 34 | 35 | 36 | | | | | | | |
| 13 | | | | | | | | | | | | | |

A. Description of original monument and accessories and/or subsequent restoration:

1838 - J. Hodgson, G.L.O.

- #1 - 8" Pine N19°W 12 Links
- #2 - 6" Pine S20°W 10 Links

Early 1900's - Old Co. Sur. Records

- #4 - 8" B. Oak S45°W 79 Links
- #5 - 8" B. Oak N65°W 138 Links

1973 - C. Cole, LS 17615

- L.C.R.C. - Liber 02, Pg. 182
- Survey recorded L. 01, Pg. 306
- "Found 1" Pipe".
- #6 - 15" W. Oak N6°E 43.81'
- #7 - 8" B. Oak S7°E 56.44'
- #8 - 12" B. Oak S67°W 62.76'

1904 - R.H. Hollister

- Set Stone with "X" on top.
- #3 - 10" J. Pine N85°E 3 Links

B. Description of corner evidence found and/or method applied in restoring of reestablishing corner:

I found a 1" x 30" Pinch Pipe in centerline of road East and West and 5 feet more or less East of old fence line to South.


Condition of the accessories are as follows: #1 Gone, #2 Gone, #3 Gone, #4 Found in good condition (20"), #5 Found stump, #6 Found Stump, #7 Found in good condition, #8 Found in good condition.

C. Description of monument for corner and accessories established to perpetuate locating the position of the corner:

I replaced the 1" pipe with a ¾" x 24" rebar with Lake County Remon Cap, and is accepted as a careful and faithful reestablishment of the position of the original corner.

- 12" W. Pine N02°W 44.91' (60d spike W. side)
- 9" W. Pine N48°W 67.33' 960d spike S.W. side)
- 6" Tw. W. Pine S69°W 81.39' (60d spike in N. side)
- 8" W. Pine S15°W 98.87' (60d spike in E. side)

NOTIFIED BY THE L.A.C. CO. DEED REVIEW GROUP
IN ACCORDANCE WITH P.A. 345
CHAIRMAN, R.L.W.
DATE 4-11-2000

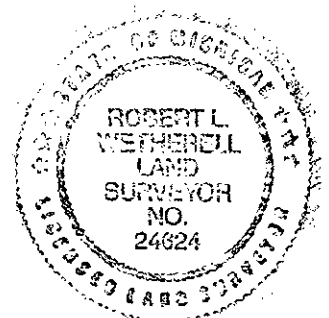

Signed by Robert L. Wetherell
Surveyor's Michigan License No. 24624

Date April 12, 2000