

JAN 25 2001

LAND CORNER RECORDATION CERTIFICATE

FILING REQUIREMENT OF ACT 74, Mich. P.A. 1970

SECTION

**RECORDED
LAKE COUNTY, MI.
LIBER 004 PAGE 0234**

MAY 5 10 25 AM '00

Shelley Myers
REGISTER OF DEEDS

For corners in Lake _____	Located in:	Corner Code#
1. Public Land Survey	T 18 N R 11 W	D-9
	T R	
	T R	
	T R	
2. Property Controlling in Section	S T R	
	S T R	
3. Miscellaneous Property in Sec.	S T R	
	S T R	
4. Lot No. _____ Recorded Plat _____		
5. Private Claims _____		

Register of Deeds Stamp & File Number

	A	B	C	D	E	F	G	H	I	J	K	L	M
1													
2	6	5	4	3	2	1							
3													
4	7	8	9	10	11	12							
5													
6	18	17	16	15	14	13							
7													
8	19	20	21	22	23	24							
9													
10	30	29	28	27	26	25							
11													
12	31	32	33	34	35	36							
13													

I, Robert L. Wetherell, in a field survey on March 17, 2000, do hereby certify that under requirements of P.A. 74, Michigan P.A. of 1970, the corner points mentioned in lines 1 and 2 above were in conformance with regulations and rules therefore as required in the current manual of survey instructions of the United States Department of the Interior, Bureau of Land Management or by decree of a Court of Law and/or that the corner points mentioned in lines 3, 4, and 5 above were in conformance with the rules of the Michigan Board of Land Surveyors or by a Decree Of a Court of Law; established, re-established, monumented, re-monumented, recovered, found as expressed below:

D-9 - 1/4 Corner common to Sections 20 & 29, T18N, R11W

A. Description of original monument and accessories and/or subsequent restoration:

1838 - J. Hodgson, G.L.O.

#1 - 10" Pine N17°W 31 Links

#2 - 8" Pine S11°E 32 Links

1904 - R. H. Hollister

Set stone with "X".

1973 - C. Cole, LS 17615

Survey recorded Liber 01, Pg. 307.

Set by single proportionate method

(2621.33' each way)

#3 - 12" B. Oak S9°W 54.56'

#4 - 8" J. Pine S43°E 42.24'

#5 - P. Pole N42°W 82.82'

1974 - John Meyers, LS 14099

Survey recorded Liber 01, Pg. 548.

Found capped iron.

#4 - 10" J. Pine S65°E 42.22'

#3 - 13" Oak South 54.46'

#5 - P. Pole N55°W 82.03'

1979 - R.L. Wetherell, 24624

Unrecorded survey File No. 3315-79

Same accessories as 1973 Cole.

1998 - R. L. Wetherell, 24624

#6 - 10" W. Pine S89°W 69.86'

#5 - P. Pole N41°W 82.96'

#7 - 4" W. Pine S38°E 72.76'

#8 - 15" B. Oak N24°E 122.31'

B. Description of corner evidence found and/or method applied in restoring or reestablishing corner:

I found a 1/2" capped iron in line with road to East and 10 feet East of centerline of road to North and 25 feet South of road to West. Road construction would have destroyed Hollister's stone so did not dig.

Condition of the accessories are as follows: #1 Gone, #2 Gone, #3 Found Stump, #4 Gone, #5 Found in good condition, #6 Found in good condition, #7 Found in good condition, #8 Found in good condition.

C. Description of monument for corner and accessories established to perpetuate locating the position of the corner:

I replaced the 1/2" rod with a 3/4" x 24" rebar with Lake County Remon Cap, and is accepted as a careful and faithful reestablishment of the position of the original corner.


10" W. Pine S89°W 69.86' (60d spike in S. side) #6

P. Pole N41°W 82.96' (60d spike in S.W. side) #5

4" W. Pine S38°E 72.76' (60d spike in W. side) #7

15" B. Oak N24°E 122.31' (60d spike in S.W. side) #8

*R.L.W.
4-11-2000*

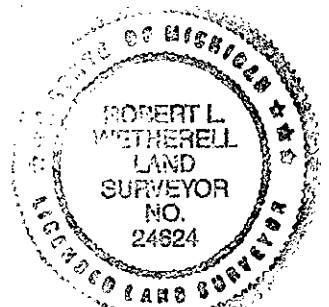

Signed by

Robert L. Wetherell

Surveyor's Michigan License No. 24624

Date 4-12-2000