

NOV 21 1997

COMMISSION

LAND CORNER RECORDATION CERTIFICATE
Filing Requirement of Act 74, Mich. P.A. 1970

RECORDED
LAKE COUNTY, MI.
LIBER 004 PAGE 0049

SEP 12 10 32 AM '97

For corners in

Lake (County)	Located In:		Corner Code #
	18N	11W	
1. Public Land Survey	T	R	E-3
	T	R	
	T	R	
	T	R	
2. Property Controlling in Section	S	T	R
	S	T	R
3. Miscellaneous Property in Sec.	S	T	R
	S	T	R

James M. DeWard
REGISTER OF DEEDS

Register of Deeds Stamp & File Number

- 4. Lot No. _____, Recorded Plat _____
- 5. Private Claims _____

A	B	C	D	E	F	G	H	I	J	K	L	M
2	6	5	4	3	2	1						
3												
4	7	8	9	10	11	12						
5												
6	18	17	16	15	14	13						
7												
8	19	20	21	22	23	24						
9												
10	30	29	28	27	26	25						
11												
12	31	32	33	34	35	36						
13												

I, Robert L. Wetherell, in a field survey on May 15, 1997, do hereby certify that under requirements of P.A. 74, Michigan P.A. of 1970, the corner points mentioned in lines 1 and 2 above were in conformance with regulations and rules therefore as required in the current manual of survey instructions of the United States Department of the Interior, Bureau of Land Management or by a decree of a Court of Law and/or that the corner points mentioned in lines 3, 4 and 5 above were in conformance with the rules of the Michigan Board of Land Surveyors or by a Decree of a Court of Law; established, re-established, monumented, re-monumented, recovered, found as expressed below:

NOTE: Not more than 4 corners, all in the same town and range, may be recorded on this certificate.

A. Description of original monument and accessories and/or subsequent restoration:

E-3 - Section corner common to Sections, 4, 5, 8 & 9, T18N, R11W, Lake Co., Mi.

- 1838 - John Hodgson, G.L.O. #1 - 8" Beech S53°E 26 Links
- 1905 - J.W. Nicholson, County Surveyor #3 - 18" Pine N42°W 30 Links
- #2 - 18" Pine N42°W 30 Links
- #4 - 8" Beech S53°E 26 Links

- 1972 - James Fraus, LS 17082
- L.C.R.C. - Liber 02, Page 158
- Found 1/2" Bar
- #5 - 12" Oak S45°E 62.06'
- #6 - 30" Oak - South 14.39'
- #7 - Concrete Monument - North 33'

(See over for continuation of "A")

B. Description of corner evidence found and/or method applied in restoring or reestablishing corner:

E-3 - Section corner common to Sections, 4, 5, 8 & 9, T18N, R11W, Lake Co., Mi.

I found a D.N.R. Brass Capped Pipe Monument 2 feet more or less South of centerline of East and West Road.

Condition of the accessories are as follows: #1 Gone, #2 Gone, #3 Gone, #4 Gone, #5 Found in good condition, #6 Found Stump, #7 Found in good condition, #8 Found stump, #9 Found in good condition, #10 Found in good condition, #11 Found in good condition.

RATIFIED BY THE LAKE CO. PEER REVIEW GROUP
IN ACCORDANCE WITH P.A. 345


CHAIRMAN R.L.W.
DATE 8-27-97

C. Description of monument for corner and accessories established to perpetuate locating the position of the corner:

E-3 - Section corner common to Sections, 4, 5, 8 & 9, T18N, R11W, Lake Co., Mi.

I accepted the D.N.R. Monument as a substantial marker for the corner, and is accepted as a careful and faithful re-establishment of the position of the original corner.

- 24" B. Oak S65°W 101.12' (60d spike in N.W. side) #11
- 22" W. Oak S54°W 72.00' (60d spike in S.E. side)
- 16" W. Oak S46°E 62.13' (60d spike in N.E. side) #5
- 13" B. Oak N29°W 70.18' (60d spike in S.W. side)

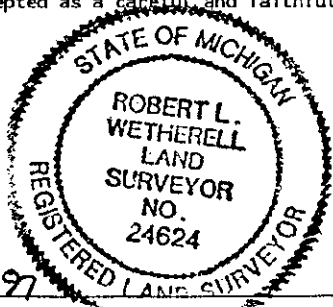

Signed by Robert L. Wetherell
24624

Date 8-27-97

Surveyor's Michigan License No. _____

A-49A

CONTINUATION OF "A" - DESCRIPTION OF ORIGINAL MONUMENT AND ACCESSORIES AND/OR SUBSEQUENT RESTORATION:

1973 - Carl Roser, D.N.R. - LS 12028

L.C.R.C. - Liber 02, Page 165

Found Iron and 2 Frank Jones witnesses.

Set D.N.R. Monument

#8 - 18" Oak S46°W 52.03'

#9 - 23" B. Oak N65°W 137.41'

#5 - 12" W. Oak S47°E 62.10'

#10 - Post - North 33'

1975 - Clinton E. Cole, LS 17615

Survey recorded Liber 02, Page 110

#7 - Concrete Monument - North 33'

#11 - 18" B. Oak S64°W 101.16'

#5 - 10" W. Oak S46°E 62.12'